

**BENOIT**  
**R 54**  
**3-29-61**

**WATER WELL DRILLERS LOG**


**CODED** *Coded*  
*TR 300*

Date: March 29, 19 61, Driller: Layne-Central Company County Bolivar

(Name)

(1) Owner of Land: <u>Benoit Elevator Co.</u> (Name)	Description & Color of Materials Sand, Clay, Red Clay, Shell, etc.	Thick- ness Feet	Depth Feet
<u>Benoit, Mississippi</u> (Address)	Clay	52	52
(2) Location: <u>26-27 T20N</u> <u>1/4, 1/4, Sec. T R SW</u>	Sand	3	55
<u>3</u> miles <u>southwest</u> , of <u>Stringtown</u> (distance) (direction) (Nearest Town)	Coarse sand, pea gravel	11	66
(3) Topography: <u>flat</u> (Hilly) (Flat) (Level)	Gravel, pea gravel	24	90
(4) Purpose of Well: <u>irrigation</u> (Domestic Irrigation Municipal, Industrial, Other)	Boulders	5	95
Information upon completion of well:			
(1) Diameter <u>12</u> inches.			
(2) Total Depth <u>95</u> feet.			
(3) Water Level <u>6' - 6"</u> feet below top of ground.			
(4) Cased to <u>55'</u> , Size <u>12"</u>			
(5) Screen: Size <u>12"</u> , Length <u>40'</u>			
(6) Were any formations sealed against pollution?			
_____ yes, <u>X</u> no.			
If YES depth of formation _____			
Why _____			
Drillers Remarks: _____			
_____			
_____			
**CODED**

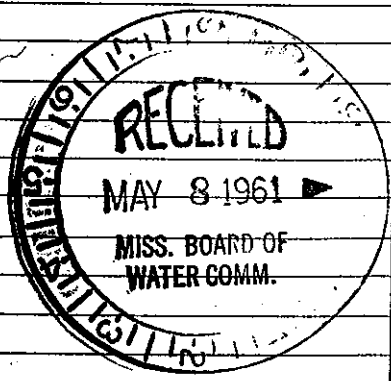

Well No.

(Use Back Side)

Mail this copy to Board of Water Commissioners 429 Miss. St. Jackson, Miss.