

BOLIVAR MISSISSIPPI BOARD OF WATER COMMISSIONERS *Coded*

~~R.56~~

7-10-63

WATER WELL DRILLERS LOG

Date: July 10, 1963, Driller: Layne-Central Company County Bolivar

(Name)

(1) Owner of Land: Delta & Pine Land Co.
(Name)

Scott, Mississippi

(Address)

(2) Location: 1/4, 1/4, Sec. 21 T. 20 N. R. 9 W.

6 miles west, of Scott
(distance) (direction) (Nearest Town)

(3) Topography: flat
(Hilly) (Flat) (Level)

(4) Purpose of Well: irrigation
(Domestic Irrigation, Municipal, Industrial, Other)

Description & Color of Material
Sand, Clay, Red Clay, Shell, etc.

Thick-
ness
Feet

Depth
Feet

Clay	9	9
Fine sand	15	24
Fine sand, clay balls	31	55
Coarse sand	20	75
Coarse sand, pea gravel	20	95
Boulders	7	102

CODED


Information upon completion of well:

- (1) Diameter 16 inches.
- (2) Total Depth 102 feet.
- (3) Water Level 16' - 2" feet below top of ground.
- (4) Cased to 52', Size 16"
- (5) Screen: Size 16", Length 50'
- (6) Were any formations sealed against pollution?
no yes, no no.

If YES depth of formation _____

Why _____

Drillers Remarks: _____

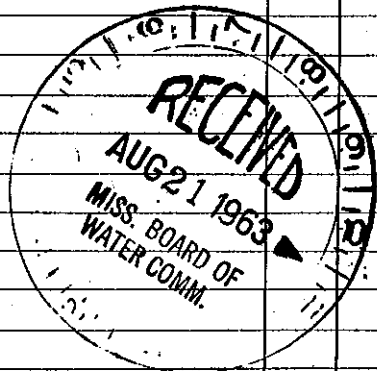

Well No.

(Use Back Side)

Mail this copy to Board of Water Commissioners 429 Miss. St. Jackson, Mis