

BOLIVAR

R 64

8-14-59


MISSISSIPPI BOARD OF WATER COMMISSIONERS

WATER WELL DRILLERS LOG

11/10/66
Jma e 706

Date: Aug. 14, 1959, Driller: Layne-Central Company County Bolivar
(Name)

(1) Owner of Land: <u>Delta & Pine Land Company</u> Rendering Plant (Name) <u>Scott, Mississippi</u> (Address)	Description & Color of Materials Sand, Clay, Red Clay, Shell, etc.	Thick- ness Feet	Depth Feet
(2) Location: <u>1/4</u> , <u>1/4</u> , Sec. <u>T</u> <u>R</u> , <u>scott</u> miles (distance) of (direction) (Nearest Town)	Clay	17	17
(3) Topography: <u>flat</u> (Hilly) (Flat) (Level)	Sandy clay	9	26
(4) Purpose of Well: <u>industrial</u> (Domestic Irrigation Municipal, Industrial, Other)	Fine sand	24	50
Information upon completion of well:	Coarse sand	25	75
(1) Diameter <u>8 3/8</u> inches.	Coarse sand & pea gravel	31	106
(2) Total Depth <u>483</u> feet.	Clay	55	161
(3) Water Level <u>28' 9"</u> feet below top of ground.	Rock	1	162
(4) Cased to <u>425'</u> , Size <u>8"</u> <u>22' lap</u>	Shale	4	166
(5) Screen: Size <u>6"</u> , Length <u>50'</u> <u>4' of 6" B.P.V.</u>	Rock	1	167
(6) Were any formations sealed against pollution? <u>yes</u> yes, <u>no</u> no.	Hard shale	33	200
If YES depth of formation <u>Cemented, mechanical seal and B.P.V.</u> Why _____	Shale, strks. sandy shale	208	408
Drillers Remarks: <u>350 GPM.</u>	Fine sand	21	429
	Sand	56	485

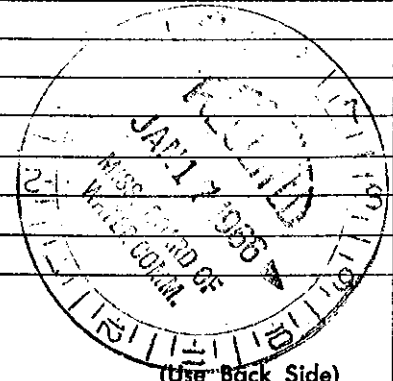

Well No.

Mail this copy to Board of Water Commissioners 429 Miss. St. Jackson, Miss