

Bolivar

R 97

3-67

CODED MISSISSIPPI BOARD OF WATER COMMISSIONERS 416 North State Street Jackson, Mississippi 39201 CODED

WATER WELL DRILLERS LOG

3-23

date well completed

1967 FIVE COUNTY FARMERS ASSN

firm name

BOLIVAR

county well located

LANDOWNER

Delta & Pine Land Co

description of formations encountered

from

to

SCOTT MISS

Sandy top soil

14

fine sand

32 1/2

46 1/2

medium sand

6 1/2

53

Sand & gravel

67

120'

Clay

11

131

(mailing address)

WELL LOCATION:

sec. 7 T. 20 N R. 9 W

1 miles West of SCOTT (distance) (direction) (nearest town)

WELL PURPOSE:

Irrigation (home, irrigation, municipal, industrial)

WELL COMPLETION DATA:

(1) diameter (inches) 6

(2) total depth (feet) 125.7'

(3) static water level (feet) 16.8' below top of ground

(4) casing pipe 77.7' (material) (depth)

6 (size) if ~~to~~ see back.

(5) screen 48 77.7' (length) (depth to top)

6 (size) Dues Metal (material)

(6) pump 30 1000 (HP) (yield gpm)


Tractor (type power)

(7) electric log no (yes or no)

(organization running log)

(8) how well bottom plugged welded

DRILLERS REMARKS:

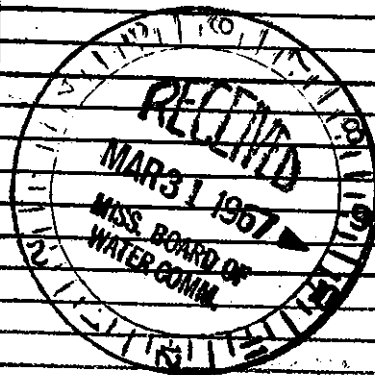

CODED