

Bolivar
R 78
3-67

MISSISSIPPI
 BOARD OF WATER COMMISSIONERS
 416 North State Street
 Jackson, Mississippi

WATER WELL DRILLERS LOG


3-24 1967 Fire Country Farmers Assn Bolivar
 date well completed firm name county well located

LANDOWNER	description of formations encountered	from	to
<u>Delta Pine Lumber</u>	<u>Sandy top soil</u>		<u>14</u>
<u>SCOTT</u>	<u>Clay</u>	<u>22 1/2</u>	<u>36 1/2</u>
<u>MISS</u>	<u>fine sand</u>	<u>33</u>	<u>40</u>
(mailing address)	<u>medium sand</u>	<u>10</u>	<u>50</u>
	<u>Coarse Sand + Gravel</u>	<u>64 1/2</u>	<u>114 1/2</u>
	<u>Clay</u>	<u>10</u>	<u>124 1/2</u>

WELL LOCATION:
 #W 5 T 20 N R 8 W
1/2 miles North of SCOTT
 (distance) (direction) (nearest town)

WELL PURPOSE: irrigation
 (home, irrigation, municipal, industrial)

- WELL COMPLETION DATA:
- (1) diameter (inches) 6"
 - (2) total depth (feet) 122' 8"
 - (3) static water level (feet) 14' 6" above top of ground.
 - (4) casing Pipe 122'
 (material) (depth)
6" if telescope see back.
 (size)
 - (5) screen 48' 74' 8"
 (length) (depth to top)
6 Open metal
 (size) (material)
 - (6) pump 30 1000
 (HP) (yield gpm)
Tractor
 (type power)
 - (7) electric log NO
 (yes or no)
 - (8) how well bottom plugged Welded

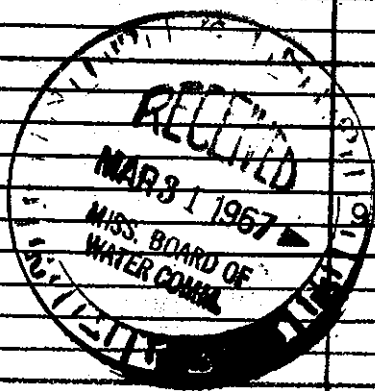

DRILLERS REMARKS: