

CODED

CODED

BOLIVAR
R 79
3-68

MISSISSIPPI
 BOARD OF WATER COMMISSIONERS
 416 North State Street
 Jackson, Mississippi 39201

WATER WELL DRILLERS LOG

3/9 1968 Bailey Drly Co Bolivar
 date well completed firm name county well located

LANDOWNER: P.D. Young
Stringtown
Miss
 (mailing address)

description of formations encountered

from to

Clay	0	25
Sand	25	80
Gravel	80	120
Mud	120	480
Sand	480	504

WELL LOCATION:

sec. 13 T. 20 N R. 8 W

In Stringtown
 (distance) (direction) (nearest town)


WELL PURPOSE:

(home, irrigation, municipal, industrial)

CODED

WELL COMPLETION DATA:

- (1) diameter (inches) 4 X 2
- (2) total depth (feet) 504
- (3) static water level (feet) 35 below top of ground.
- (4) casing Steel 489
 (material) (depth)
4 X 2 if telescope see back.
 (size)
- (5) screen 15' 489
 (length) (depth to top)
2" Stainless Steel
 (size) (material)
- (6) pump 1 20
 (HP) (yield gpm)
elec
 (type power)
- (7) electric log No
 (yes or no)
- (organization running log)
- (8) how well bottom plugged back pressure valve

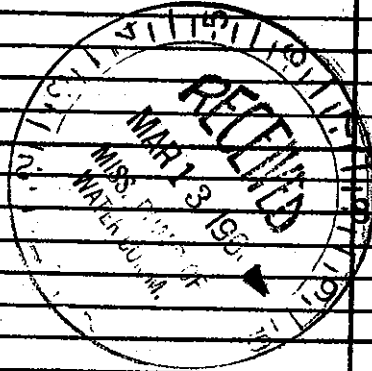

DRILLERS REMARKS: