

BOLIVAR
R 81
4-68

MISSISSIPPI
 BOARD OF WATER COMMISSIONERS
 416 North State Street
 Jackson, Mississippi 39201

WATER WELL DRILLERS LOG

4-12 1968 ZWCC COMPANY 7 ARNER ASSN Bolivar
 date well completed firm name county well located

LANDOWNER: Delta + Pine Land Co description of formations encountered from to
SCOTT MISS Clay + topsoil 20 1/2
 (mailing address) Fine Sand 66
 Coarse Sand + gravel 165


WELL LOCATION:
 sec. 18 T 20 N R 8 W
4 miles SE of SCOTT
 (distance) (direction) (nearest town)

WELL PURPOSE: irrigation
 (home, irrigation, municipal, industrial)

WELL COMPLETION DATA:
 (1) diameter (inches) 6
 (2) total depth (feet) 111
 (3) static water level (feet) 10 below above top of ground.
 (4) casing PIPE 63
 (material) (depth)
6 if telescope see back.
 (size)
 (5) screen 48 63
 (length) (depth to top)
6 DAEM 101
 (size) (material)
 (6) pump 40 1400
 (HP) (yield gpm)

(type power)
 (7) electric log NO
 (yes or no)
 (organization running log)
 (8) how well bottom plugged Welded

| description of formations encountered | from | to |
|---------------------------------------|--------|----|
| Clay + topsoil | 20 1/2 | |
| Fine Sand | 66 | |
| Coarse Sand + gravel | 165 | |
| Clay at 165 | | |

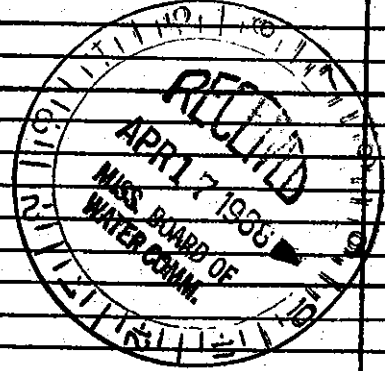

DRILLERS REMARKS: