

BOLIVAR MISSISSIPPI BOARD OF WATER COMMISSIONERS

R 83

9-15-64 WATER WELL DRILLERS LOG

9/24/64
me 1886
CODED

Date: Sept. 15, 1964, Driller: Layne-Central Company, County Bolivar
(Name)

(1) Owner of Land: Ralph Ray
(Name)

Benoit, Mississippi
(Address)

(2) Location: $\frac{1}{4}$, $\frac{1}{4}$, Sec. 5 T21N R8W,
5 miles southwest, of Benoit
(distance) (direction) (Nearest Town)

(3) Topography: flat
(Hilly) (Flat) (Level)

(4) Purpose of Well: irrigation
(Domestic Irrigation Municipal, Industrial, Other)

Description & Color of Materials Sand, Clay, Red Clay, Shell, etc.	Thick- ness Feet	Depth Feet
Sandy clay	11	11
Brown sand	27	38
Coarse sand	13	51
Coarse sand & small pea gravel	57	108
Clay	1	109
CODED		

Information upon completion of well:

(1) Diameter 3 inches.

(2) Total Depth 94' 1" feet.

(3) Water Level 23 feet below top of ground.

(4) Cased to 83' 11", Size 3"


(5) Screen: Size 3", Length 10' 3"

(6) Were any formations sealed against pollution?
yes yes, no no.

If YES depth of formation Packer above the screen and a B.P.V. at bottom.

Why

Drillers Remarks:

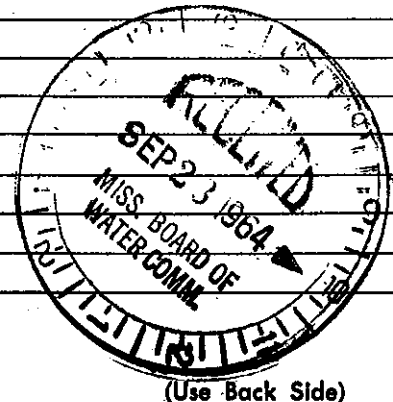

Well No.

Mail this copy to Board of Water Commissioners 429 Miss. St. Jackson, Miss.