

BOLIVAR MISSISSIPPI BOARD OF WATER COMMISSIONERS

R 85

1-20-65

WATER WELL DRILLERS LOG

C1887

Date: Jan. 20, 1965, Driller: Layne-Central Company County Bolivar

(Name)

(1) Owner of Land: Delta & Pine Land Co.

(Name)

Scott, Mississippi

(Address)

T20N

(2) Location: 1/4, 1/4, Sec. 20 T. R8W

2 miles Southeast of Scott

(distance)

(direction)

(Nearest Town)

(3) Topography: flat

(Hilly)

(Flat)

(Level)

(4) Purpose of Well: irrigation

(Domestic Irrigation
Municipal, Industrial, Other)

Information upon completion of well:

(1) Diameter 16" inches.

(2) Total Depth 105 feet.

(3) Water Level 10' 6" feet below top of ground.

(4) Cased to 55', Size 16"

(5) Screen: Size 16", Length 50'

(6) Were any formations sealed against pollution?

yes, no

If YES depth of formation

Why

Drillers Remarks:

Description & Color of Materials
Sand, Clay, Red Clay, Shell, etc.

Thick-
ness
Feet

Depth
Feet

Sandy clay

0

10

Clay

32

42

Coarse sand

25

67

Gravel & sand

28

95

Boulders & sand

10

105


Clay

2

107

CODED

CODED

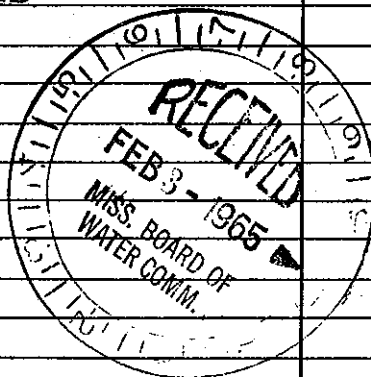

Well No.

(Use Back Side)

Mail this copy to Board of Water Commissioners 429 Miss. St. Jackson, Miss.