

**BOLIVAR** MISSISSIPPI BOARD OF WATER COMMISSIONERS

R. 86  
3-8-65


**WATER WELL DRILLERS LOG**

DUPLICATED  
3/15/65 1941 9850

Date: March 8, 1965, Driller: Layne-Central Company County Bolivar

(Name)

(1) Owner of Land: <u>Delta &amp; Pine Land Co.</u> (Name)	Description & Color of Materials Sand, Clay, Red Clay, Shell, etc.	Thick- ness Feet	Depth Feet
<u>Scott, Mississippi</u> (Address)	<u>Sandy clay</u>	<u>4</u>	<u>4</u>
(2) Location: <u>1/4, 1/4, Sec. 23 T. 8N, R. 8W</u> <u>Fallback Plantation.</u> _____ miles _____ of <u>Scott</u> (distance) (direction) (Nearest Town)	<u>Clay</u>	<u>17</u>	<u>21</u>
(3) Topography: <u>Flat</u> (Hilly) (Flat) (Level)	<u>Blue clay with fine sand strks.</u>	<u>18</u>	<u>39</u>
(4) Purpose of Well: <u>domestic</u> (Domestic Irrigation Municipal, Industrial, Other)	<u>Fine sand</u>	<u>12</u>	<u>51</u>
Information upon completion of well:	<u>Coarse sand</u>	<u>27</u>	<u>78</u>
(1) Diameter <u>4</u> inches.	<u>Coarse sand &amp; pea gravel</u>	<u>53</u>	<u>131</u>
(2) Total Depth <u>548</u> feet.	<u>Blue clay</u>	<u>9</u>	<u>140</u>
(3) Water Level <u>34</u> feet below top of ground.	<u>Clay with sandy clay</u>	<u>32</u>	<u>172</u>
(4) Cased to <u>502' 7"</u> , Size <u>4"</u>	<u>Fine sand &amp; clay strks.</u>	<u>34</u>	<u>206</u>
(5) Screen: Size <u>4"</u> Length <u>30' 5"</u> <u>15' B.P.V. 4"</u>	<u>Clay with sandy clay</u>	<u>34</u>	<u>240</u>
(6) Were any formations sealed against pollution? <u>yes</u> yes, _____ no.	<u>Sand</u>	<u>18</u>	<u>258</u>
If YES depth of formation <u>Packer above</u> <u>the screen. B.P.V.</u>	<u>Clay</u>	<u>5</u>	<u>263</u>
Why _____	<u>Sandy clay</u>	<u>12</u>	<u>275</u>
Drillers Remarks: _____	<u>Clay</u>	<u>42</u>	<u>317</u>
	<u>Shale with sandy shale</u>	<u>41</u>	<u>358</u>
	<u>Clay</u>	<u>30</u>	<u>388</u>
	<u>Fine sand &amp; clay strks.</u>	<u>22</u>	<u>410</u>
	<u>Sand</u>	<u>135</u>	<u>545</u>
	<u>Clay</u>	<u>3</u>	<u>548</u>

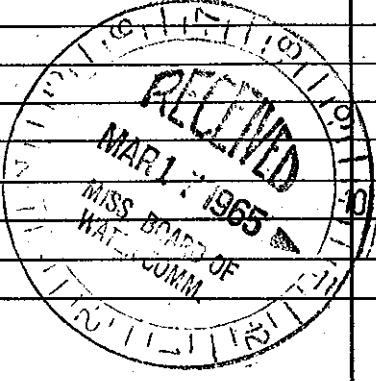

(Use Back Side)

Well No.

Mail this copy to Board of Water Commissioners 429 Miss. St. Jackson, Miss.