

BOLIVAR MISSISSIPPI BOARD OF WATER COMMISSIONERS

R 87
S-13-66

WATER WELL DRILLERS LOG

5/19/66
2192

Date: May 13, 1966, Driller: Layne-Central Company County Bolivar

(Name)

(1) Owner of Land: <u>Saw Grass Lake, Inc.</u> (Name)	Description & Color of Materials Sand, Clay, Red Clay, Shell, etc.	Thick- ness Feet	Depth Feet
<u>Benoit, Mississippi</u> (Address)	Surface sand	23	23
T20N	Fine gray sand & clay	19	42
(2) Location: <u>1/4</u> , <u>1/4</u> , Sec. <u>16</u> T <u>20</u> N R <u>8</u> W	Fine gray sand	3	45
<u> </u> miles <u> </u> of <u>Benoit</u> (distance) (direction) (Nearest Town)	Coarse sand	17	62
(3) Topography: <u>flat</u> (Hilly) (Flat) (Level)	Coarse sand, little gravel	6	68
(4) Purpose of Well: <u>irrigation</u> (Domestic Irrigation Municipal, Industrial, Other)	Coarse sand, gravel & little clay	4	72
	Coarse sand	20	92
	Coarse sand, gravel, little clay at bottom	25	117

CODED

Information upon completion of well:

(1) Diameter 16 inches.

(2) Total Depth 117 feet.

(3) Water Level 12 feet below top of ground.

(4) Cased to 72', Size 16"


(5) Screen: Size 16", Length 45'

(6) Were any formations sealed against pollution?
 yes, no no.

If YES depth of formation _____

Why _____

Drillers Remarks: _____

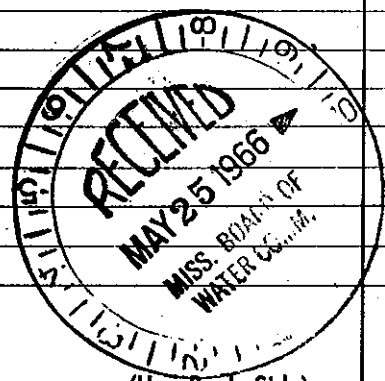

(Use Back Side)

Well No.

Mail this copy to Board of Water Commissioners 429 Miss. St. Jackson, Miss.