

BOLIVAR MISSISSIPPI BOARD OF WATER COMMISSIONERS

R 89 CODED


WATER WELL DRILLERS LOG

4-1-63

4/3/63
1513

Date: April 1, 19 63, Driller: Layne-Central Company County Bolivar
(Name)

	Description & Color of Materials Sand, Clay, Red Clay, Shell, etc.	Thick- ness Feet	Depth Feet
(1) Owner of Land: <u>Delta & Pine Land Co.</u> <u>Lamont Gin</u> (Name) <u>Scott, Mississippi</u> (Address)	Clay	23	23
(2) Location: <u>1/4, 1/4, Sec. 37 T20N R9W</u> <u>Scott</u> (Nearest Town) _____ miles _____ of _____ (distance) (direction)	Find sand	9	32
(3) Topography: <u>flat</u> (Hilly) (Flat) (Level)	Coarse sand	48	80
(4) Purpose of Well: <u>industrial</u> (Domestic Irrigation, Municipal, Industrial, Other)	Coarse sand & pea gravel	17	97
Information upon completion of well:	Coarse sand & gravel	23	120
(1) Diameter <u>6x4</u> inches.	Clay	42	162
(2) Total Depth <u>532'-9"</u> feet.	Hard white clay	10	172
(3) Water Level <u>42</u> feet below top of ground.	Shale	32	204
(4) Cased to <u>128'</u> , Size <u>6"</u>	Sand	22	226
(5) Screen: Size <u>4"</u> , Length <u>31'3"</u>	Sand strks. (shale) CODED	15	241
(6) Were any formations sealed against pollution?	Shale	42	283
<u>yes</u> yes, _____ no.	Sand	17	300
If YES depth of formation. Packer above the screen and back pressure valve at the bottom.	Shale	10	310
Drillers Remarks:	Sandy shale	9	319
	Hard shale	7	326
	Shale	34	360
	Clay	27	387
	Shale	9	396
	Fine sand CODED	12	408
	Shale strks. clay	18	426
	Clay	48	474
	Sand strks. shale	10	484
	Sand	48	532
	Sandy shale		532

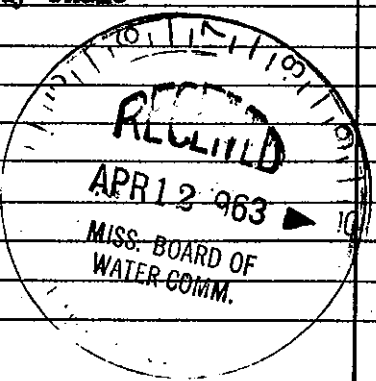

Well No.

(Use Back Side)

Mail this copy to Board of Water Commissioners 429 Miss. St. Jackson, Miss.