

BOLIVAR MISSISSIPPI BOARD OF WATER COMMISSIONERS

R 90
9-1-62


WATER WELL DRILLERS LOG

C1410

Date: Sept. 1, 1962, Driller: Layne-Central Company County Bolivar

(Name)

	Description & Color of Materials Sand, Clay, Red Clay, Shell, etc.	Thick- ness Feet	Depth Feet
(1) Owner of Land: <u>Delta & Pine Land Co.</u> (Name)	Sandy clay	8	8
<u>Scott, Mississippi</u>	Clay balls CODED	58	66
<u>Belmont Plantation</u> (Address)	Sand pea gravel	100	166
(2) Location: <u>1/4</u> , <u>1/4</u> , Sec. <u>30</u> T <u>20N</u> R <u>8W</u>	Blue clay	18	184
<u>4</u> miles <u>south</u> , of <u>Scott</u> (distance) (direction) (Nearest Town)	Sandy shale	64	248
(3) Topography: <u>flat</u> (Hilly) (Flat) (Level)	Blue clay	58	306
(4) Purpose of Well: <u>domestic</u> (Domestic Irrigation Municipal, Industrial, Other)	Rock	1	307
Information upon completion of well:	Sandy shale	68	375
(1) Diameter <u>4</u> inches.	Gummy clay	61	436
(2) Total Depth <u>534' -4"</u> feet.	White fine sand	8	444
(3) Water Level <u>43' -2"</u> feet below top of ground.	Sandy shale	44	488
(4) Cased to <u>500' -6"</u> , Size <u>4"</u>	Fine sand shale	6	494
(5) Screen: Size <u>4"</u> , Length <u>30' -10"</u> <u>3' B.P.V.</u>	Rock sand	40	534
(6) Were any formations sealed against pollution? <u>yes</u> yes, <u>no</u> no.	Shale		535
If YES depth of formation _____	CODED		
Why <u>Sealed with packer at the top of the screen.</u>			
To eliminate all other formations. Drillers Remarks:			

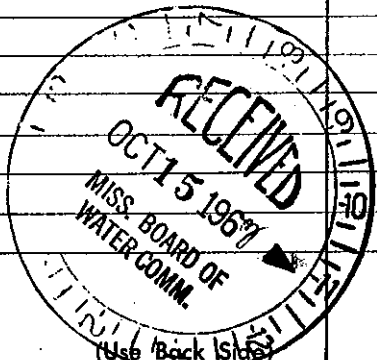

Well No.

Mail this copy to Board of Water Commissioners 429 Miss. St. Jackson, Mis