

Bolivar
R 108
4-20-81

MISSISSIPPI
BOARD OF WATER COMMISSIONERS
416 North State Street
Jackson, Mississippi 39201

CODED

WATER WELL DRILLERS LOG

4-20-81 date well completed 1981 FABRICATION WELL & SUPPLY, INC. firm name BOLIVAR county well located

LANDOWNER:	description of formations encountered	from	to
PRUDENTIAL INS. CO. P.O. BOX 4679 GREENVILLE MS 38701 (mailing address)	TOP SOIL - CLAY	0	10
	CLAY	10	20
	FINE SAND	20	30
	" "	30	40
	COARSE SAND	40	50
	COARSE SAND & GRAVEL	50	60
	" " "	60	70
	" " "	70	80
	" " "	80	94

LANDOWNER: DELTA PINE LUMBER

WELL LOCATION:
sec. 10 T 20 N R 8 E
15 miles N of G'VILLE
(distance) (direction) (nearest town)

WELL PURPOSE: Irrigation
(home, irrigation, municipal, industrial)

WELL COMPLETION DATA:

(1) diameter (inches) 16"

(2) total depth (feet) 94'

(3) static water level (feet) 20 below above top of ground.


(4) casing METAL, 54'
(material) (depth)
(size) if telescope see back.

(5) screen 40' 54'-94'
(length) (depth to top)
16", METAL
(size) (material)

(6) pump 80 1400
(HP) (yield gpm)
DIESEL
(type power)

(7) electric log NO
(yes or no)
(organization running log)

(8) how well bottom plugged Welded PLATE

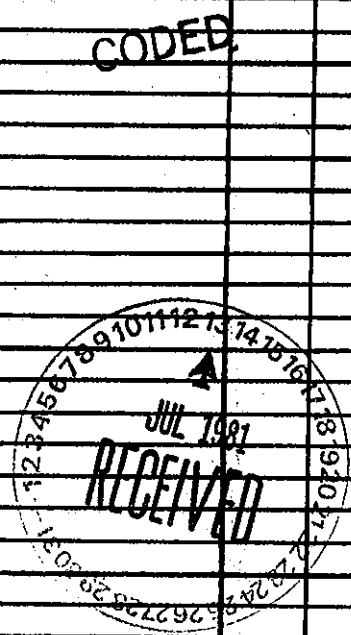

DRILLERS REMARKS: