

Charlie Nelson

State Well Report

Part 1

Mississippi Department of Environmental Quality
Office of Land and Water Resources
P.O. Box 10631
Jackson, MS 39289-0631
(601)961-5210
(601)354-6938 (fax)

For Office Use Only:

Aquifer: _____
Well #: R-203
L. S. Elevation: _____
E-log #: _____

County: BOLIVAR
Permit #: 60243194
Driller: J. NEWCOME
Date drilling completed: 4-21-09

State Law requires that this report be prepared by the driller in detail and filed with the Department within 30 days of completion of drilling of the well.

Well Owner Information	Well Location
Owner Name: <u>N + N Farms</u>	Latitude: <u>33.33.07"</u> Longitude: <u>90.5P.32"</u>
Mailing Address: <u>1/2 Charlie Nelson</u> <u>627 Stringtown Rd</u> <u>Benoit, MS 38725</u> City State Zip Code	Method of Lat/Long (circle one): Conventional Survey, USGS quad, <u>Hand-held GPS</u> , Survey-grade GPS <u>NW 1/4 SE 1/4 Sec 25 Twn 20 N Rng 8 W</u> NE Direction Nearest Town <u>7.5</u> Miles <u>SE</u> of <u>BENOIT</u>
Telephone No. <u>(662) 620-9948</u>	

Well Data

Purpose of Well (circle one) Home Industrial Public Supply Irrigation Fish Culture Other: _____

Date well drilling started: 4-21-09 Date well drilling completed: 4-21-09

If flowing, method of flow regulation: Valve _____ Other (describe) _____

Static Water Level: _____ feet above or below (circle one) land surface Date measured: _____

Method of Measurement (circle one) steel tape electric tape air line other: _____

Hole depth: 104 Well depth: 103 Well grouted to a depth of 10 feet

Type of grout (circle one): Cement Bentonite Mix

Casing length: 70 feet Casing diameter: 12 inches Type of casing: PVC

Screen length: 33 feet Screen diameter: 12 inches Type of screen: PVC

Screen slot size: .050 inches Setting depth: From 50-65-77-87 feet to 95-103 feet

Type of completion (circle all applicable): Gravel packed Underreamed Telescoped Open hole Natural Development
Other (describe): _____

Top of lap pipe or reduction in casing: _____ feet. If telescoped or more than one screen, describe on back of page

Logs run (circle all applicable): No log run Electric Gamma Ray Density Sonic Neutron Other: _____

Name of organization running log(s): _____

I certify that the well was drilled, constructed, and completed in accordance with all applicable requirements of the Mississippi Department of Environmental Quality and/or the Mississippi Department of Health regulations and state laws.

JOHN NEWCOME 0-7773
Print Name of Water Well Contractor and License No.


John Newcome
Signature of Water Well Contractor

RECEIVED
MAY 08 2009
BY: OLWR

R-203

If well telescopes please sketch below and show depths.


Ground Level

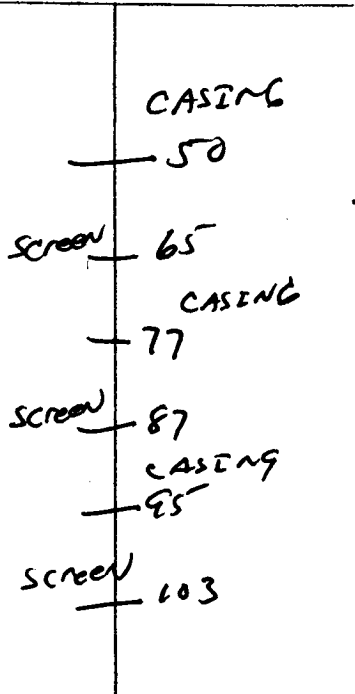

Description of Formations Encountered	From	To
TOP Soil	0	10
MIX CLAY	10	38
FINE SAND	38	50
COARSE SAND	50	65
FINE SAND	65	77
COARSE SAND	77	87
FINE SAND	87	95
COARSE SAND ROCK'S	95	103
SLATE	103	104

If more than one screen, show location of each on sketch

Sketch the property layout and include the following: 1) the well location; 2) any permanent structures on the property that may aid in locating the well; 3) any roads, power lines, or other items that may aid in locating the property and the well; 4) indicate direction.

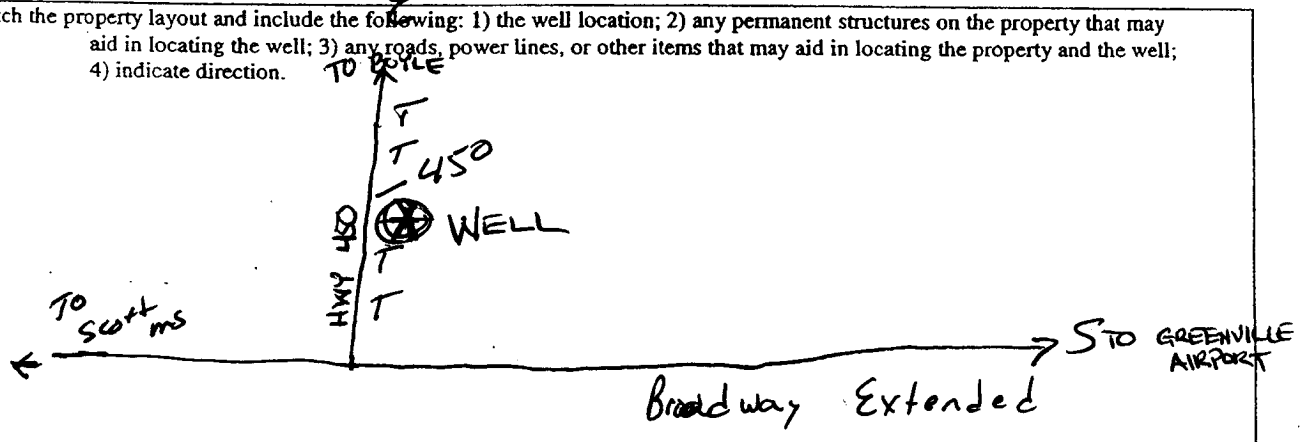

Landowner Name: _____

John New...
Signature of Water Well Contractor

STATE WELL REPORT

Part 2

Pump Installer's Completion Report
 Mississippi Department of Environmental Quality
 Office of Land and Water Resources
 P.O. Box 10631
 Jackson, MS 39289-0631
 (601)961-5210
 (601)354-6938 (fax)

For Office Use Only:

Aquifer: _____
 Well #: R-203
 Elevation: _____

County: Bolivar
 Permit #: 6W43194
 Driller: J. Newcome
 Date completed: 4-21-09

This report should be prepared by the pump installer in detail and filed with the Department within 30 days of the installation of pump.

Well Owner Information	Well Location
Owner Name: <u>N + N Farms</u>	Latitude: <u>33° 33' 07"</u> Longitude: <u>90° 58' 32"</u>
Mailing Address: <u>% Charlie Nelson</u> <u>607 Stringtown LA</u> <u>Benoit, MS 38725</u> City State Zip Code	Method of Lat/Long (circle one): Conventional Survey, USGS quad <u>Hand-held GPS</u> , Survey-grade GPS <u>NW</u> ¼ <u>SE</u> ¼ Sec <u>25</u> Twn <u>20N</u> Rng <u>8W</u>
Telephone No. <u>662 820-9948</u>	Distance Direction Nearest Town <u>7.5</u> Miles <u>SE</u> of <u>Benoit</u>

Pump Type Circle one	Power Type Circle one
Air Lift Jet <input type="radio"/> <u>Submersible</u> <input checked="" type="radio"/>	Diesel Engine Gasoline Engine Natural Gas
Bucket Piston Turbine <input type="radio"/>	<u>Electric Motor</u> <input checked="" type="radio"/> Hand Tractor PTO
Centrifugal Rotary Flowing Well <input type="radio"/>	Windmill Other (specify): _____
Other (specify): _____	Horse Power Rating of Motor: <u>30</u>
Date Pump Installed: <u>4-21-09</u>	Setting Depth: <u>70</u> feet
Rated Pump Capacity: <u>1200</u> Gallons Per Minute	Number of Stages: <u>1</u>

Pump Test Data	Method of Measuring Water Level Circle one
Date Well Tested: _____	Air Line Electric Measuring Line Steel Tape
Static Water Level (A): _____ Feet Below Land Surface	Other (specify): _____
Pumping Water Level (B): <u>N.T.</u> Feet Below Land Surface	For flowing well, measured shut in head: _____ feet
Drawdown [(B) - (A)]: _____ Feet Below Land Surface	Well yielded _____ GPM with a drawdown of _____ feet after _____ hours of pumping
Test Pumping Rate: _____ Gallons Per Minute	
Duration of Pump Test (minimum 4 hours): _____ hours	

I HEREBY CERTIFY that the above statements are true to the best of my knowledge.

Cony Rowe 0-711P
 Print Name of Pump Installer and License No. (if applicable)

[Signature]
 Signature of Pump Installer

RECEIVED

MAY 08 2009

BY: OLWR