
١.	GAyland.									
1		State We	ell Report							
	County: BOLIVAK		urt 1	For Office Use Only:						
.*	Permit #: 6W 44514	Mississippi Department Office of Land ar	of Environmental Quality ad Water Resources	Aquifer: <u>R 2/3</u>						
	Driller: J. NEWCOME 0.773		ox 10631	Well #:						
٩	Date drilling completed: 7-20-10		S 39289-0631 061-5210	L. S. Elevation:						
	Date drining completed.		-6938 (fax)	E-log #:						
	State Law requires that this report be prepared by the driller in detail and filed with the Department within 30 days of completion of drilling of the well.									
		Well Owner Information We								
	Owner Hame - Color	andingt	" Longitude: 91 . 05, 45,							
	Mailing Address: (O Gaulon Lourence Method of Lat/Long (circle one): Conventional Survey,									
	POBOX	d GPS? Survey-grade GPS								
	City State Zip Code NE 4 Sec 25 Twn 21N Rng 9W									
		•	Distance Direction	20 N Nearest Town of <u>Scott ms</u>						
	Telephone No. ()									
	Well Data * replacement									
	Purpose of Well (circle one) Home In	dustrial Public Supply (Irrigation Fish Culture	Other: For Gw 06 \$75						
	Date well drilling started: 7-20-	LO Date	well drilling completed:	-20-10						
	If flowing, method of flow regulation: V	alve Other (o	lescribe)							
	Static Water Level:feet	above or below (circle one)	land surface Date measured	l:						
		od of Measurement (circle one) steel tape electric tape air line other:								
	Hole depth: <u>103</u> Well									
	Type of grout (circle one): Cement Bentonite Mix									
	Casing length: <u>70</u> feet Casing diameter: <u>16</u> inches Type of casing: <u>PrC</u>									
. ·	Screen length: <u>30</u> feet Screen diameter: <u>16</u> inches Type of screen: <u>PVC</u>									
	Screen slot size: 050 inche	s Setting depth: From	70 feet to	100 feet						
	Type of completion (circle all applicable): Gravel packed Underreamed Telescoped Open hole Natural Development									
		Other (describe):								
	Top of lap pipe or reduction in casing:feet. If telescoped or more than one screen, describe on back of page									
	Logs run (circle all applicable) No log run Electric Gamma Ray Density Sonic Neutron Other:									
	Name of organization running log(s):									
	Department of Environmental Quality and/or the Mississippi Department of Health regulations and state laws.									
	JOHN NEWCOME	0-173	- you	- Newc-e						
,	Print Name of Water Well Contractor a	nd License No.	' Signature	e of Water Well Contractor						
オ		1 emerse		MIL OT OFFICENED						
50	moved - m	cotton u	vell, and	L NO POINT						
1.4	ic applied &	for price	in to dr	TILLE THE THE AND						
		۲		U BYTOWR						

If well telescopes please sketch below and show depths.

N

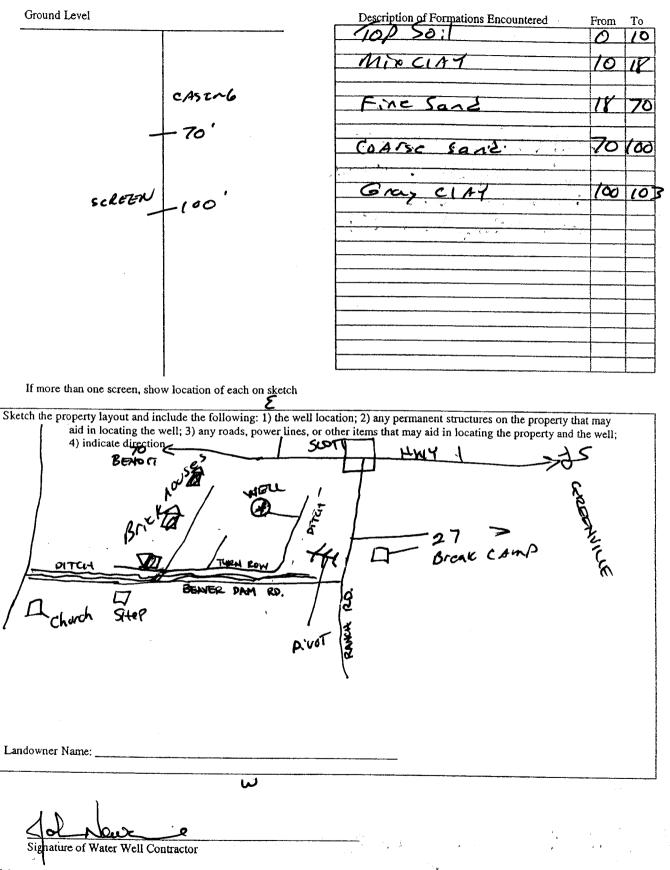

ł

	STATE WE	ELL REPORT		
County: Bolicar Permit #: Driller J. New Come Date completed: 7-20-10 This report should be prepared by the	Pump Installer's Mississippi Departmen Office of Lánd a P.O. I Jackson, M (601) (601)35	art 2 completion Report t of Environmental Quality and Water Resources Box 10631 IS 39289-0631 961-5210 4-6938 (fax)	For Office Use Only Aquifer: \mathcal{R} \mathcal{P} \mathcal{L} Well #:	3
This report should be prepared by the installation of pump. Well Owner Information		W	ell Location	
Owner Name: DEITEL Fire Mailing Address: <u>C 10</u> Gov <u>PO Box</u> <u>City</u> State	57669 MS 38709 Zip Code	Rethod of Lat/Long (circle	nd-held GP8, Survey-grade G Twn 21 Rng 8 20 N Nearest Town	
Pump Type Circle one Air Lift Jet	Submersible		Power Type Circle one line Engine Natural	
Bucket Piston	Turbine	Electric Motor Han		
Centrifugal Rotary Other (specify): Date Pump Installed:	Flowing Well	Windmill Other Horse Power Rating of Mot Setting Depth:C		
Rated Pump Capacity:	_Gallons Per Minute	Number of Stages:	2	
Pump Test Data Date Well Tested: Static Water Level (A):Fee			Aeasuring Water Level Circle one easuring Line Steel Ta	pe
Pumping Water Level (B):Fee Drawdown [(B) - (A)]:Fge	t Below Land Surface	Other (specify):	sbut in head:	feet
	Gallons Per Minute	Well yielded	GPM with a drawdown of pure	of
I HEREBY CERTIFY that the above state Print Name of Homp Installer and License	O-TIIP	of my knowledge	AUG 1 9 20 JU	AUG 192

•.....

× • • •

the formation of the second states and the

м. м. ^с