GATION. TABLE #8

.

	State Well Report	
County: BOLIVAR	Part 1 – Driller's Log	For Office Use Only:
Permit #: (5K) - 46746	ississippi Department of Environmental Quality Office of Land and Water Resources	
Driller: J. NEWCOME 0.773	P.O. Box 2309	Well #: <u>R230</u>
Date drilling completed: 3.21.13	Jackson, MS 39225 (601)961- 5210	L. S. Elevation:
	(601)961- 5228 (fax)	E-log #:
	prepared by the license holder responsible for	
Department at the above address wit Information on Well Own	<i>hin 30 days of completion of drilling of the w</i> er Well or	ell or borehole. Rorehole Location
(Landowner if borehole is not for a		H" Longitude: 91 .01 .11 "
Owner Name DELTA PINE LAND CO.	MPANY LP	
Mailing Address: P.a. Bux 5669	Method of Lat/Long (circle	e one): Conventional Survey,
-	USGS quad, Hand-he	eld GPS, Survey-grade GPS
Case due of Mas	28704 5W 1/4 Sec_ 14	0/Twn ZON Rng OBW
GREENVILLE M5 City State	Zip Code Distance Direction	n Nearest Town
Telephone No. ()	<u> </u>	of SCOTT
	Well / Borehole Data	\neg .)^
Date drilling started: $3 \cdot 21 \cdot 13$ Date drilling	g completed: 3.21.13 Hole depth: 112	Hole diameter: 24
Location of the source of any surface water us	ed for drilling: SLOUEH	~~ ~
Method of dosing and volume of Chlorine use	ed for drilling: <u>SLIGE</u> ed in drilling and development: <u>CHLORINE</u>	THISLETS
Logs run (circle all applicable): No log run E Name of organization running log(s):	Electric Gamma Ray Density Sonic Neutron	Other:
Purpose of borehole (check one): Water Well	Geotechnical/Geological Investigation Grou	ind Source Heat Pump
Seismic Surv	ey_Other (describe)Replaces	GW10219
	vater well construction, skip the remainder of this	
Purpose of Well (check one): Home Indus	trialPublic Supply Irrigation_XFish Cultur	re Other:
If a flowing well, method of flow regulation: N	/alve Other (describe)	
Static Water Level:feet above	or below (circle one) land surface Date measured	d:
Method of Measurement (circle one) steel t	ape electric tape air line other:	
	of 10 feet Type of grout (circle one): Neat C	
	ameter: <u> </u>	
	iameter: inches Type of screen:	
Screen slot size: .050 inches	Setting depth: From 70 feet to	10feet
Type of completion (circle all applicable)	avel packed Underreamed Telescoped Op	en hole Natural Development
O	ther (describe):	
Top of lap pipe or reduction in casing:	feet. If telescoped or more than one sc	reen, describe on next page
		APR 1 8 2013
		BY: OLWR

.

The sketch below only required for water wells Description of formations encountered must be provided for all wells and boreholes, unless specifically exempted by regulations If well telescopes, show depths on sketch. Ground Level_ **Description of Formations Encountered** From (depth) To (depth) TOP SOIL Ground Level 10 SAND 10 40 MEDIUM SAND 40 ω COARSE GANN Ъ <u>60</u> COARSE FANDIPERIO 20 110 BOTTOM 110 112 IUF (S'CASING

If more than one screen, show location of each on sketch

Sketch the property layout and include the following: 1) the well location; 2) any permanent structures on the property that may aid in locating the well; 3) any roads, power lines, or other items that may aid in locating the property and the well; 4) a north arrow. RECEIVED SEE MAR BY: OLWR Landowner Name: Form: OLWR-SWR-1A (04/08)

I certify that the well/borehole was drilled, constructed, and completed in accordance with all applicable requirements of the Mississippi Department of Health regulations, if applicable, and state laws.

D :: 3.21.2013 JOHN ENCOME

Ω

Print Name of Responsible Licensee and License No.

Date

Signature of Licensee


[·······	STATE WI	ELL REPORT			
$\begin{array}{c} \text{county: } Bol ivar \\ \text{connit #: } GW. 46746 \\ \text{miller: } J. Wewcome 6.773 \\ \text{Date completed: } 3-21.2013 \\ \end{array}$		Part 2 s Completion Report at of Environmental Quali- and Water Resources Box 10631 MS 39289-0631 0961-5210 54-6938 (fax)	Ty Aquifer. Well #: <u>R.2</u> Elevation:	Well #:	
Well Owner Informatio		· · · · · · · · · · · · · · · · · · ·	Well Location		
Owner Name: De Ita Pine La. Mailing Address: P.O. Box 56 <u>Greenville MS</u> City State Telephone No. ()	29	Lat/Long (1 USGS quad <u>Sw 45</u> W 14 S Distance Direc	$\frac{44}{2} \text{Longitude: } \frac{91}{2}$ $\frac{4}{2} \text{Longitude: } \frac{91}{2}$ $\frac{1}{2} \text{Longitude: } \frac{91}{2}$ 1	urvey.	
Pump Type Circle one		· · · · · · · · · · · · · · · · · · ·	Power Type		
Air I ift	Submersible		Circle one		
Bucket	Turbine		·	Natural Gas	
Centrificeal	Flowing Well			Tractor PTO	
Other (specify):			Other (specify):		
Date Pump Installed: 3-26-2 Rated Pump Capacity: 3000 G	OI 3 Fallons Per Minute	Number of Stages:	I		
Pump Test Data		Mathod	en e		
Date Well Tested:		Medidi	of Measuring Water Leve Circle one	L	
Drawdown [(B) - (A)]: For B	low Land Surface	Other (specify):	c Measuring Line St	eel Tape	
Test Pumping Rate:G			GPM with a drawe		
Duration of Pump Test (minimum 4 hours):	bows		fterbours		
HEREBY CURTUPY - 4 DW FROM Hubbard Stephens Print Name of Pump Installer and License No.	NILL	Information Signature of Pu	RECEIV		
		:	BY: OL	ŴR	

and state of the second se

3 <u>1</u> 8

•

R230

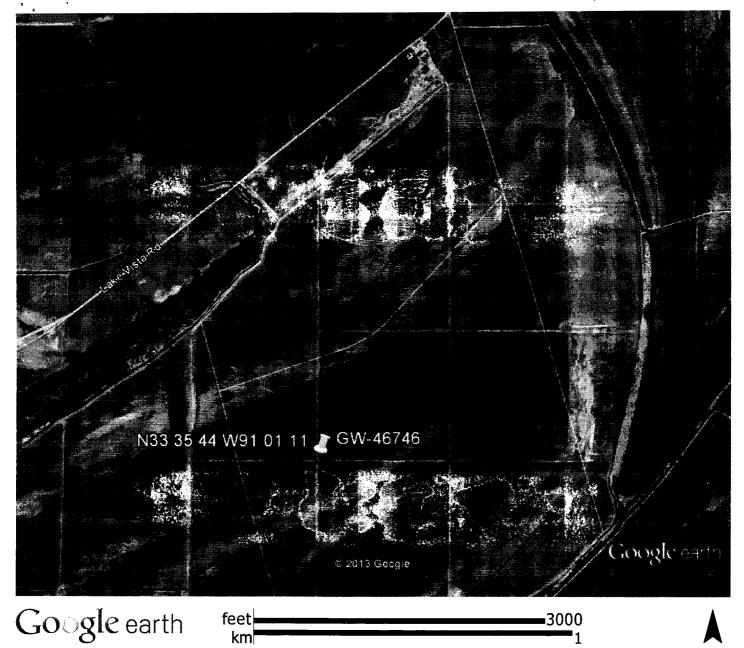



APR 1 8 2013 BY: OLWR