County: BOLIVAR
Permit #: <u>GW-47468</u> √
Driller: J. NEWCOME 0.773
Date drilling completed: 6.22.13

STATE WELL REPORT

Part 1

Driller's Log
Mississippi Department of Environmental Quality
Office of Land and Water Resources P.O. Box 2309 Jackson, MS 39225-2309

(601)961-5210 (601)360-0535 (fax)

For Office Use Only: Well #: 239	
Aquifer:	
E-Log #:	

State Law requires that this report be prepared by the license holder responsible for the work and filed with the Department at the above address within 30 days of completion of drilling of the well or borehole.

Well Owner Information	Well or Borehole Location			
(Landowner if borehole is not for a water well)	Latitude: 33'34'52 Longitude: 091' 00'57e"			
Owner Name: Delta Pine land Managener				
Mailing Address: P.O. Box 5669	Method of Lat/Long (check one): Conventional Survey,			
	USGS quad, Hand-held GPS, Survey-grade GPS			
Granulle MS 38704 City State Zip Code	NE 1 SW 14, Sec 15 T 20N R 08W			
City State Zip Code	3.5 Miles EAST of ScoTT			
Telephone No. ()	(Distance) (Direction) (Nearest Town)			
Wall / B	orehole Data			
	6.22 13 Hole depth: 102 Hole diameter: 24"			
Location of the source of any surface water used for drilling	· · · · · · · · · · · · · · · · · · ·			
Method of dosing and volume of Chlorine used in drilling a	nd development: CITCALINE TABLET			
=	na Ray Density Sonic Neutron Other:			
Name of organization running log(s):	loces 37723			
Purpose of borehole (circle one) Water Wett Geotechni	cal/Geological Investigation Ground Source Heat Pump			
Seismic Survey Other ((describe)			
If drilling is not related to water well co	onstruction, skip the remainder of this block			
Purpose of Well (circle all applicable): Home Industrial	Public Supply Irrigation Fish Culture			
Other (describe):				
If a flowing well, method of flow regulation: Valve	Other (describe)			
Static Water Level:feet [above or below] land surface Date measured: (circle one)				
Method of measurement (circle one): Steel tape Electric tape Air line Other (describe):				
Well depth: 100 Well grouted to a depth of: 10 feet Type of grout (circle one): Neat Cement Bentonite Mix				
Casing length:				
Screen length: 40 feet Screen diameter: 16 inches Type of screen: P.V.C.				
Screen slot size:				
Type of completion (circle all applicable): Gravet packets Underreamed Open hole Natural Development				
Other (describe):				
Top of lap pipe or reduction in casing:feet				
If telescoped or more than one screen, describe on next page				

Form: OLWR-SWR-1A (4/13)

If well telescopes, show depths on sketch.	Permit #: GWA7ALS	!	For Office Use	Only:	
Ground Level Description of Formations Encountered From (depth) To (depth)		Description of formations encountered must be provided for all wel and boreholes, unless specifically exempted by regulations			
Sketch the property layout and include the following: 1) the well location 2) any permanent structures on the property that may aid in locating the well 3) any roads, power lines, or other items that may aid in locating the property and the well 4) north arrow Andowner Name: HEREBY CERTIFY that the well/borehole was drilled, constructed, and completed in accordance with all applicable equirements of the Mississippi Department of Environmental Quality and the Mississippi Department of Health regulations, applicable, and state laws.	Ground Level (e) LF 1Le' CAHWO	DA SOIL SACY) MEDIUM SACUD MEDIUM (CONCIE SACID CONESE SACID MEDIUM SACID CLAY	Ground level LO 570 67 80 97	50 65 80 87 98 100	
HEREBY CERTIFY that the well/borehole was drilled, constructed, and completed in accordance with all applicable equirements of the Mississippi Department of Environmental Quality and the Mississippi Department of Health regulations, applicable, and state laws.	ketch the property layout and include the following: 1) the well location 2) any permanent structures on the property that may aid 3) any roads, power lines, or other items that may aid in	d in locating the well locating the property and the well			
HEREBY CERTIFY that the well/borehole was drilled, constructed, and completed in accordance with all applicable equirements of the Mississippi Department of Environmental Quality and the Mississippi Department of Health regulations, applicable, and state laws.	See	MR			
applicable, and state laws.					
int Name of Responsible Licensee and License No. Date Signature of Licensee	applicable, and state laws.	erical Quality and the Mississippi Departi	e with all applica ment of Health re	ble gulations,	

STATE WELL REPORT

County: Bolivar Permit #: 6W-47468 Driller: J. Nasconc Date completed:

Copy information from block on Part 1


Part 2 **Pump Installer's Completion Report**

Mississippi Department of Environmental Quality Office of Land and Water Resources P.O. Box 2309 Jackson, MS 39225-2309 (601)961-5210 (601) 360-0535 (fax)

For Office Use Only:				
Well #:	R239			
Aquifer:				

	well contractor or a licensed pump installer. A copy of Part 1 epartment at the above address within 30 days of well completion.			
Well Owner Information	Well Location			
Owner Name: Delta Pine land Management	Latitude: 33.34 52 Longitude: 91 00 56"			
Mailing Address: P.O. Bax 5649	Method of Lat/Long (check one): Conventional Survey,			
A	USGS quad, Hand-held GPS <u></u> , Survey-grade GPS			
City State Zip Code	WE 1/4 SW 1/4, Sec 15 T 20N R 08W			
Telephone No. ()	$\frac{35}{\text{(Distance)}}$ Miles $\frac{E_{55}V}{\text{(Direction)}}$ of $\frac{5c_0H}{\text{(Nearest Town)}}$			
	pe (circle one)			
Submersible Turbine Air Lift Centrifugal Flowing Well				
	lated Pump Capacity: 1800 Gallons Per Minute			
Is This Pump (circle one): (New) Repaired Replacemen				
	pe (circle one)			
Electric Diese Gasoline Natural Gas Tractor PTO Wind				
Horse Power Rating of Motor: <u>LC</u> Setting Dept	h: 70 feet Number of Stages: 2			
	for Non Flowing Well			
Date Well Tested:	Duration of Pump Test (minimum 4 hours): hours			
Static Water Level (A): Feet Below Land Surface	Duration of Pump Test (minimum 4 hours): hours Pumping Water Level (B): Feet Below Land Surface			
Drawdown [(B) - (A)]:Feet Below Land Surf	ace Test Pumping Rate:Gallons Per Minute			
Method of measurement (circle one): Steel tape Electric ta	pe Air line Other (<i>describe</i>):			
• .	a for Flowing Well			
Measured shut in head:feet. $ ightharpoonup ightharpoonup $	ested			
Well yieldedGPM with a drawdown of	feet afterhours of pumping			
Meter Installation				
Meter Manufacturer:	Meter Serial Number:			
Meter Manufacturer:	Type of Meter:			
Totalizer Register Unit and Multiplier Factor (AF x .001, gal x 1000, etc):				
Installation Date: Meter installed by:				
Is This Meter (circle one): New Repaired Replacement	nt 📆 z system			
Important: By submitting the above information you are certifying that this meter was installed to manufacturer standards. For agricultural wells, a list of approved meters is on the MDEQ website.				
I HEREBY CERTIFY that the above statements are true to the best of my knowledge.				
Hubbard Stephers 741-P 7-20-13 Hubbard Stephers Print Name of Pump Installer and License No. (if applicable) Date Signature of Pump Installer				
Print Name of Pump Installer and License No. (if applicable)	Date Signature of Pump Installer			

Form: OLWR-SWR-1B (4/13)

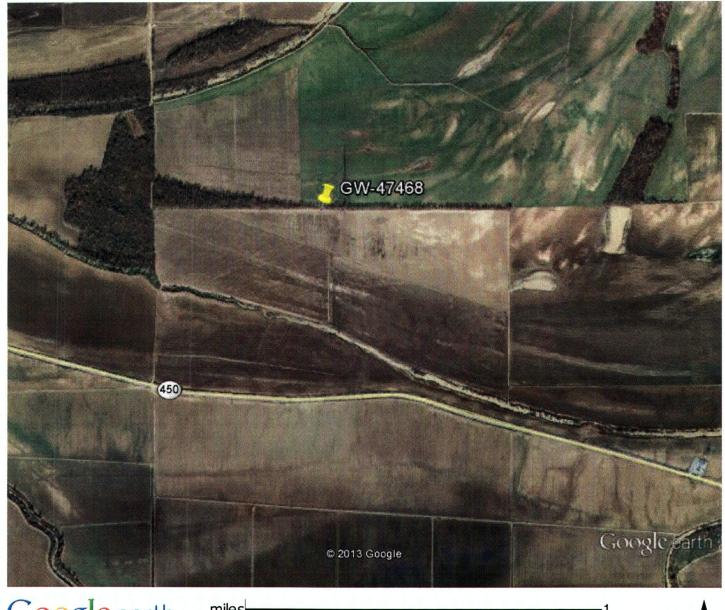

Google earth

miles 1

RECEIVED

AUG 0 5 2013

BY: OLWR