

file

State Well Report

County: Bolivar
 Permit #: GW41645
 Driller: Charles M. Nichols
 Date drilling completed: 3-20-07

Part 1 - FIVE M
 Mississippi Department
 Office of Land and Water Resources
 P.O. Box 10631
 Jackson, MS 39289-0631
 (601)961-5210
 (601)354-6938 (fax)

For Office Use Only:
 Aquifer: _____
 Well #: R243
 L. S. Elevation: _____
 E-log #: _____

State Law requires that this report be prepared by the license holder responsible for the work and filed with the Department at the above address within 30 days of completion of drilling of the well or borehole.

<p>Information on Well Owner (Landowner if borehole is not for a water well)</p> <p>Owner Name: <u>FIVE M FARMING</u> Mailing Address: <u>111 CREEK HARBOR DR</u> <u>GREENVILLE MS 38701</u> City State Zip Code Telephone No. () _____</p>	<p>Well or Borehole Location</p> <p>Latitude: <u>33° 35' 20" N</u> Longitude: <u>091° 02' 18" W</u> Method of Lat/Long (circle one): Conventional Survey, USGS quad, <u>Hand-held GPS</u>, Survey-grade GPS _____ 1/4 _____ 1/4 Sec _____ Twn _____ Rng _____ Distance Direction Nearest Town <u>2</u> Miles <u>SE</u> of <u>SCOTT</u></p>
--	--

Well / Borehole Data

Date drilling started: 3-20-07 Date drilling completed: 3-20-07 Hole depth: 103 Hole diameter: 28 in

Location of the source of any surface water used for drilling: Deer Creek
 Method of dosing and volume of Chlorine used in drilling and development: granulated HTA

Logs run (circle all applicable): No log run Electric Gamma Ray Density Sonic Neutron Other: _____
 Name of organization running log(s): _____

Purpose of borehole (check one): Water Well Geotechnical/Geological Investigation _____ Ground Source Heat Pump _____
 Seismic Survey _____ Other (describe) _____
If drilling is not related to water well construction, skip the remainder of this block

Purpose of Well (check one): Home _____ Industrial _____ Public Supply _____ Irrigation _____ Fish Culture Other: _____

If a flowing well, method of flow regulation: Valve _____ Other (describe) _____

Static Water Level: 16 feet above or below (circle one) land surface Date measured: 3-20-07

Method of Measurement (circle one) steel tape electric tape air line other: _____

Well depth: 103 Well grouted to a depth of 10 feet Type of grout (circle one): Neat Cement Bentonite Mix

Casing length: 73 feet Casing diameter: 16 inches Type of casing: PVC

Screen length: 30 feet Screen diameter: 16 inches Type of screen: PVC

Screen slot size: .035 inches Setting depth: From 73 feet to 103 feet

Type of completion (circle all applicable): Gravel packed Underreamed Telescoped Open hole Natural Development
 Other (describe): _____

Top of lap pipe or reduction in casing: _____ feet. *If telescoped or more than one screen, describe on next page*

Form: OLWR-SWR-1A

RECEIVED


APR 17 2007


YMD JOINT WATER MANAGEMENT DISTRICT

41645

The sketch below only required for water wells

If well telescopes, show depths on sketch

Ground Level 

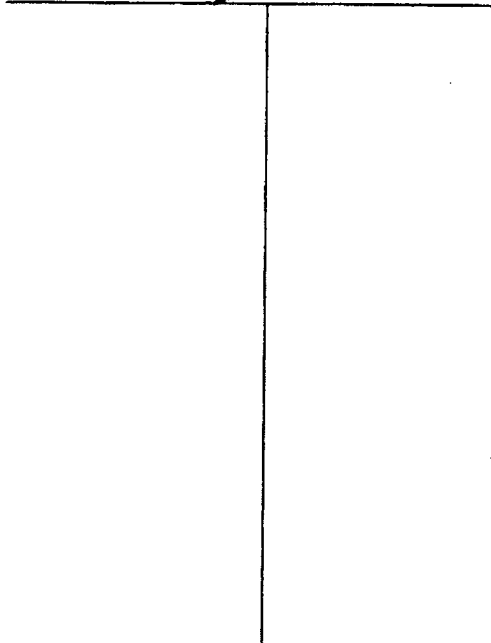


Description of formations encountered must be provided for all wells and boreholes, unless specifically exempted by regulations

Description of Formations Encountered	From (depth)	To (depth)
clay	Ground Level	46
Fine sand	46	60
Fine to med. sand	60	75
Course sand	75	90
Course sand w/ gravel + gravel	90	97
cemented gravel	97	98
clay	98	103

If more than one screen, show location of each on sketch

Sketch the property layout and include the following: 1) the well location; 2) any permanent structures on the property that may aid in locating the well; 3) any roads, power lines, or other items that may aid in locating the property and the well; 4) a north arrow.

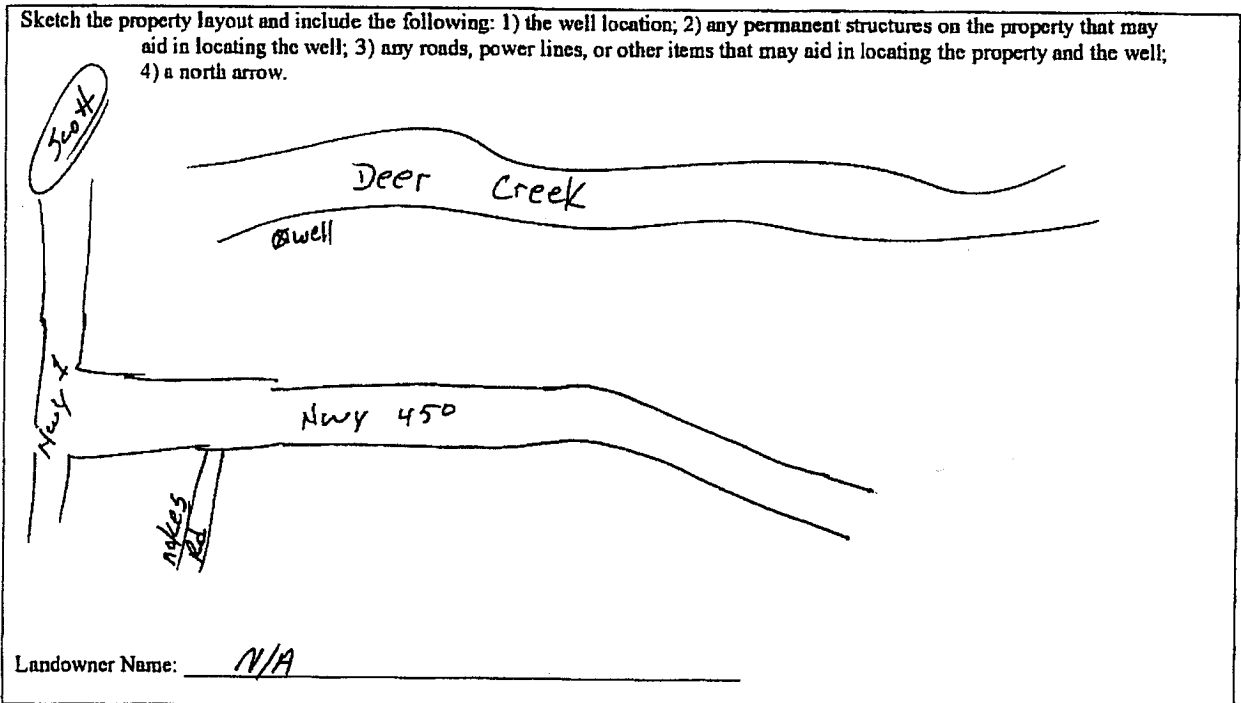

Landowner Name: N/A

Form: OLWR-SWR-1A

I certify that the well/borehole was drilled, constructed, and completed in accordance with all applicable requirements of the Mississippi Department of Environmental Quality and the Mississippi Department of Health regulations, if applicable, and state laws.

Charles M. Nichols 0-0667 4-11-07 *Charles M. Nichols*
 Print Name of Responsible Licensee and License No. Date Signature of Licensee