

GAYLAW

# STATE WELL REPORT

## Part 1

### Driller's Log

Mississippi Department of Environmental Quality  
Office of Land and Water Resources  
P.O. Box 2309  
Jackson, MS 39225-2309  
(601)961-5210  
(601)360-0535 (fax)

#### For Office Use Only:

Well #: R 247  
Aquifer: \_\_\_\_\_  
E-Log #: \_\_\_\_\_

County: BOLIVAR  
 Permit #: GLW-43866 ✓  
 Driller: J. NEWCOME 0-773  
 Date drilling completed: 4-11-14

*State Law requires that this report be prepared by the license holder responsible for the work and filed with the Department at the above address within 30 days of completion of drilling of the well or borehole.*

| Well Owner Information<br>(Landowner if borehole is not for a water well) | Well or Borehole Location  |
|---|--|
| Owner Name: <u>DELTA PINE LAND MGT LLC</u>                                | Latitude: <u>N33° 30' 23"</u> Longitude: <u>W091° 00' 54"</u>  |
| Mailing Address: <u>PO Box 5669</u>                                       | Method of Lat/Long (check one): Conventional Survey _____, USGS quad _____, Hand-held GPS <input checked="" type="checkbox"/> , Survey-grade GPS _____ |
| <u>GREENVILLE</u> MS <u>38704</u>   | <u>NE 1/4 SW 1/4, Sec 3</u> ✓ T <u>20N</u> R <u>8W</u>   |
| City State Zip Code   | <u>4</u> Miles <u>E</u> of <u>SCOTT</u>  |
| Telephone No. (____) _____  | (Distance) (Direction) (Nearest Town)  |

**Well / Borehole Data**

Date drilling started: 4-11-14 Date drilling completed: 4-11-14 Hole depth: 122 Hole diameter: 24"

Location of the source of any surface water used for drilling: DITCH

Method of dosing and volume of Chlorine used in drilling and development: CHLORINE TABLETS

Logs run (circle all applicable):  No log run Electric Gamma Ray Density Sonic Neutron Other: \_\_\_\_\_

Name of organization running log(s): \_\_\_\_\_

Purpose of borehole (circle one):  Water Well Geotechnical/Geological Investigation Ground Source Heat Pump  
Seismic Survey Other (describe) \_\_\_\_\_

*If drilling is not related to water well construction, skip the remainder of this block*

Purpose of Well (circle all applicable): Home Industrial Public Supply  Irrigation Fish Culture

Other (describe): \_\_\_\_\_

If a flowing well, method of flow regulation: Valve \_\_\_\_\_ Other (describe) \_\_\_\_\_

Static Water Level: \_\_\_\_\_ feet [above or below] land surface Date measured: \_\_\_\_\_  
(circle one)

Method of measurement (circle one): Steel tape Electric tape Air line Other (describe): \_\_\_\_\_

Well depth: 120 Well grouted to a depth of: 10 feet Type of grout (circle one): Neat Cement  Bentonite Mix

Casing length: 80 feet Casing diameter: 16 inches Type of casing: P.V.C.

Screen length: 40 feet Screen diameter: 16 inches Type of screen: P.V.C.

Screen slot size: .050 inches Setting depth: From 80 feet to 120 feet

Type of completion (circle all applicable):  Gravel packed Underreamed Open hole Natural Development

Other (describe): \_\_\_\_\_

Top of lap pipe or reduction in casing: \_\_\_\_\_ feet


*If telescoped or more than one screen, describe on next page*

County: Bolivar  
Permit #: MS-6W-43866

**For Office Use Only:**  
Well #: R247

The sketch below only required for water wells

If well telescopes, show depths on sketch.

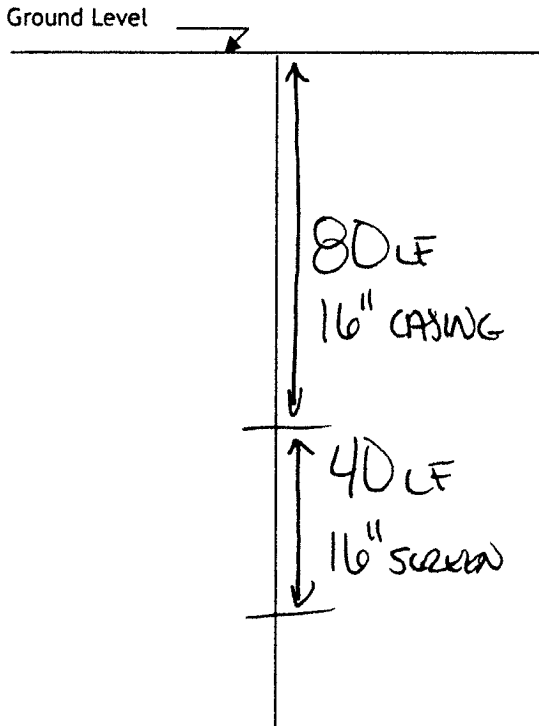

If more than one screen, show location of each on sketch

Description of formations encountered must be provided for all wells and boreholes, unless specifically exempted by regulations

| Description of Formations Encountered | From (depth) | To (depth) |
|---------------------------------------|--------------|------------|
| TOP SOIL                              | Ground level | 10         |
| CLAY                                  | 10           | 30         |
| SAND/CLAY STRIPS                      | 30           | 50         |
| MED. GRADE SAND/PEBBLE STRIPS         | 50           | 120        |
| RD 100                                | 120          | 122        |
|                                       |              |            |
|                                       |              |            |
- Sketch the property layout and include the following:
- 1) the well location
  - 2) any permanent structures on the property that may aid in locating the well
  - 3) any roads, power lines, or other items that may aid in locating the property and the well
  - 4) north arrow

SEE MAP

Landowner Name: \_\_\_\_\_

I HEREBY CERTIFY that the well/borehole was drilled, constructed, and completed in accordance with all applicable requirements of the Mississippi Department of Environmental Quality and the Mississippi Department of Health regulations, if applicable, and state laws.

JOHN NEWOME 0.773      4.11.14      [Signature]  
Print Name of Responsible Licensee and License No.      Date      Signature of Licensee

# STATE WELL REPORT

## Part 2

**Pump Installer's Completion Report**  
 Mississippi Department of Environmental Quality  
 Office of Land and Water Resources  
 P.O. Box 2309  
 Jackson, MS 39225-2309  
 (601)961-5210  
 (601) 360-0535 (fax)

County: Bolivar  
 Permit #: GW-43866  
 Driller: J. Newcome 0-773  
 Date completed: 4-11-14  
*Copy information from block on Part 1*

**For Office Use Only:**

Well #: R 247  
 Aquifer: \_\_\_\_\_

*This part of the report must be completed by a licensed water well contractor or a licensed pump installer. A copy of Part 1 of the report must be attached and both parts filed with the Department at the above address within 30 days of well completion.*

| Well Owner Information                     | Well Location  |
|--|--|
| Owner Name: <u>Delta Pine Land MGT LLC</u> | Latitude: <u>N35° 26' 23"</u> Longitude: <u>91° 00' 54"</u>  |
| Mailing Address: <u>P.O. Box 5669</u>      | Method of Lat/Long (check one): Conventional Survey _____, USGS quad _____, Hand-held GPS <input checked="" type="checkbox"/> , Survey-grade GPS _____ |
| <u>Greenville</u> MS <u>38704</u>          | <u>NE 1/4 SW 1/4, Sec 3 T 20N R 8W</u>   |
| City State Zip Code                        | <u>4</u> Miles <u>E</u> of <u>Scott</u>  |
| Telephone No. (____) _____                 | (Distance) (Direction) (Nearest Town)  |

**Pump Type (circle one)**

Submersible  Turbine Air Lift Centrifugal Flowing Well Jet Piston Rotary Other (describe): \_\_\_\_\_

Date Pump Installed: 4/12/14 Rated Pump Capacity: 2500 Gallons Per Minute

Is This Pump (circle one):  New Repaired Replacement

**Power Type (circle one)**

Electric  Diesel Gasoline Natural Gas Tractor PTO Windmill Other (describe): \_\_\_\_\_

Horse Power Rating of Motor: 60<sup>HP</sup> Setting Depth: 70 feet Number of Stages: 1

**Pump Test Data for Non Flowing Well**

Date Well Tested: Not Tested Duration of Pump Test (minimum 4 hours): \_\_\_\_\_ hours

Static Water Level (A): \_\_\_\_\_ Feet Below Land Surface Pumping Water Level (B): \_\_\_\_\_ Feet Below Land Surface

Drawdown [(B) - (A)]: \_\_\_\_\_ Feet Below Land Surface Test Pumping Rate: \_\_\_\_\_ Gallons Per Minute

Method of measurement (circle one): Steel tape Electric tape Air line Other (describe): \_\_\_\_\_

**Pump Test Data for Flowing Well**

Measured shut in head: \_\_\_\_\_ feet. Not Tested

Well yielded \_\_\_\_\_ GPM with a drawdown of \_\_\_\_\_ feet after \_\_\_\_\_ hours of pumping

**Meter Installation**

Meter Manufacturer: M'Cometer Meter Serial Number: 14-0474910

Meter Model Number/Name: M0310 Type of Meter: propeller

Totalizer Register Unit and Multiplier Factor (AF x .001, gal x 1000, etc): gal x 100

Installation Date: 4/17/14 Meter installed by: Chicot Irrigation

Is This Meter (circle one): New Repaired Replacement

*Important: By submitting the above information you are certifying that this meter was installed to manufacturer standards. For agricultural wells, a list of approved meters is on the MDEQ website.*

I HEREBY CERTIFY that the above statements are true to the best of my knowledge.

Hubbard Stephens 741-P 4/17/14 [Signature]

Print Name of Pump Installer and License No. (if applicable) Date Signature of Pump Installer



Google earth



*[Faint handwritten notes]*