

BOLIVAR

MISSISSIPPI BOARD OF WATER COMMISSIONERS

R 2000

7-17-59

WATER WELL DRILLERS LOG

1/10/66

mc 709

Date: July 17, 1959, Driller: Layne-Central Company County Bolivar

(Name)

(1) Owner of Land: Delta & Pine Land Company Asia Plantation (Name) Scott, Mississippi (Address)

(2) Location: 1/4, 1/4, Sec. 2 T20 R9, miles, of Scott (distance) (direction) (Nearest Town)

(3) Topography: flat (Hilly) (Flat) (Level)

(4) Purpose of Well: domestic (Domestic Irrigation Municipal, Industrial, Other)

Description & Color of Materials Sand, Clay, Red Clay, Shell, etc.	Thick- ness Feet	Depth Feet
Clay	23	23
Coarse sand	80	103
Coarse sand & pea gravel	18	121
Clay	24	145
Shale	36	181
Fine sand	16	197
Shale	32	229
Rock	1	230
Fine sand	30	260
Shale	92	352
Sandy shale, fine sand	38	390
Sand, P.K. medium. fine	29	419
Sand, P.K. medium	84	503

Information upon completion of well:


- (1) Diameter 4 inches.
- (2) Total Depth 503'11" feet.
- (3) Water Level 28 feet below top of ground.
- (4) Cased to 463'11", Size 4"
- (5) Screen: Size 4", Length 30'
- (6) Were any formations sealed against pollution?  
yes yes, no.

If YES depth of formation Packer above the screen and shot at bottom.

Why

Drillers Remarks:

50 GPM.

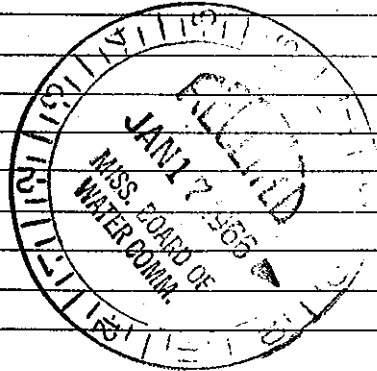

(Use Back Side)

Well No.

Mail this copy to Board of Water Commissioners 429 Miss. St. Jackson, Miss