

MISSISSIPPI DEPARTMENT OF ENVIRONMENTAL QUALITY

Office of Land and Water Resources

P. O. Box 10631
Jackson, MS 39289-0631
WATER WELL DRILLERS LOG

COUNTY WELL LOCATED Bolivar
WELL NUMBER CODED R 296
DATE WELL COMPLETED 31 July 98

PERMIT NUMBER
NAME OF DRILLING FIRM Lambert Drilling

NAME & MAILING ADDRESS OF LANDOWNER Rufus Robinson Lament, ms.			
WELL LOCATION	SEC	TOWNSHIP	RANGE
	37	20	S 9 E
DISTANCE	DIRECTION	NEAREST TOWN	
10 Miles	n	of Greenville	
OTHER LANDMARK			
WELL PURPOSE: Home, Irrigation, Municipal, Industrial, Fish Pond, etc. Home			

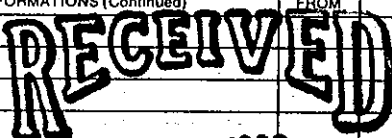
PUMP DATA		
PUMP TYPE (Circle One): Submersible, Turbine, Jet, Flowing Well, Other (Describe) _____		
POWER TYPE (Circle One): Electric, Tractor, Diesel, Gasoline, Butane, Other (Describe) _____ H/P _____		
Pump Capacity (GPM) 20	No. of Stages 8	Setting Depth 105 FT.
PUMP TEST		
Well yielded _____ GPM with a drawdown of _____ ft. after _____ hours of pumping		

WELL DATA		
Well Depth 500	Casing Diameter (In.) 4X2	Casing Length (Ft.) 480
Type of Casing PVC	Hole Depth 500	Depth to Static Water Level 56
TYPE OF COMPLETION: (Circle One or More): Gravel Packed, Underreamed, Telescoped, Natural Development, Open Hole, Other (Describe) _____		
WELL GROUTED TO A DEPTH OF _____ FEET Type Grout (circle one): Cement, Bentonite, or Mix		

LOG DATA	
TYPE OF LOG RUN (Circle One): No Log Run, Electric, Gamma Ray, Density, Sonic, Neutron, Other (Describe) _____	
Name of Organization Running Log	

SCREEN DATA		
Diameter - Inches 2"	Length - Feet 20	Slot Size - Inches 10
Screen Type PVC Ribbed	Depth to Bottom - Feet 480-500	

GEOLOGIC DATA (Office Use Only)			
Surface Elev.	Geologic Unit	Unit Thickness	Depth to Top
Subs. SWL	Date	Analysis	Aquifer Test
Driller's Remarks			

DESCRIPTION OF FORMATIONS ENCOUNTERED	FROM	TO	FORMATIONS (Continued)	
			FROM	TO
 RECEIVED SEP 09 1998 Dept of Environmental Quality Office of Land & Water Resources				

IF MORE SPACE IS NEEDED, USE BACK