

**BOLIVAR MISSISSIPPI BOARD OF WATER COMMISSIONERS**

S 43  
5-2-62

**WATER WELL DRILLERS LOG**

Date: 5/2, 1962, Driller: Delta Well Supply Co County Bolivar  
(Name)

(1) Owner of Land:	Description & Color of Materials Sand, Clay, Red Clay, Shell, etc.	Thick- ness Feet	Depth Feet
<u>John J. Smith</u> (Name)	<u>Top soil</u>	<u>18</u>	<u>18</u>
<u>Cleveland Miss.</u> (Address)	<u>yellow sand clay</u>	<u>5</u>	<u>21</u>
(2) Location: <u>1/4</u> , <u>1/4</u> , Sec. <u>29</u> T <u>20</u> R <u>7</u> ,	<u>Fine Gray Sand</u>	<u>20</u>	<u>51</u>
<u>6</u> miles <u>S.E.</u> , of <u>Berrett</u>	<u>Sand &amp; Gravel</u>	<u>12</u>	<u>63</u>
(distance) (direction) (Nearest Town)	<u>" Brown</u>	<u>17</u>	<u>80</u>
(3) Topography: <input checked="" type="checkbox"/> (Hilly) <input type="checkbox"/> (Flat) <input type="checkbox"/> (Level)	<u>Clay &amp; Gravel</u>	<u>6</u>	<u>86</u>
(4) Purpose of Well: <u>Irrigation</u>	<u>Sand &amp; Gravel</u>	<u>11</u>	<u>97</u>
(Domestic Irrigation Municipal, Industrial, Other)	<u>large Gravel</u>	<u>4</u>	<u>101</u>


Information upon completion of well:

- (1) Diameter 16 inches.
- (2) Total Depth 101 feet.
- (3) Water Level 18 feet below top of ground.
- (4) Cased to \_\_\_\_\_, Size 16"
- (5) Screen: Size 16", Length 40 ft.
- (6) Were any formations sealed against pollution?  
\_\_\_\_\_ yes,  no.

If YES depth of formation \_\_\_\_\_

Why \_\_\_\_\_

Drillers Remarks: \_\_\_\_\_

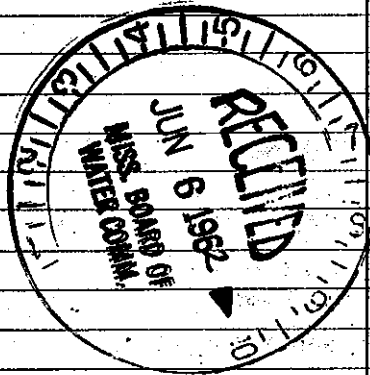

(Use Back Side)

Well No.

Mail this copy to Board of Water Commissioners 429 Miss. St. Jackson, Miss