

Bolivar  
549  
10/67

MISSISSIPPI  
 BOARD OF WATER COMMISSIONERS  
 416 North State Street  
 Jackson, Mississippi 39201

*10/30/67*  
*JW*  
*Well #2*  
*C2556*  
**CODED**

**WATER WELL DRILLERS LOG**

October 24, 1967 Layne-Central Company Bolivar  
 date well completed firm name county well located

LANDOWNER: Verl Fullen	description of formations encountered	from	to
Shaw, Mississippi (mailing address)			
WELL LOCATION: sec. <u>B T 20</u> R. <u>7 E</u> S <u>5</u>	Sand	20	35
	Coarse sand	35	48
	Coarse sand & pea gravel	48	65
	Coarse sand	65	70
	Coarse sand & pea gravel	70	78
6 miles southeast of Benoit (distance) (direction) (nearest town)	Coarse sand & gravel	78	112

WELL PURPOSE: irrigation  
 (home, irrigation, municipal, industrial)


WELL COMPLETION DATA:

- (1) diameter (inches) 12
- (2) total depth (feet) 112
- (3) static water level (feet) 21.8 above top of ground.
- (4) casing steel, 72'  
 (material) (depth)  
12" if telescope see back.  
 (size)
- (5) screen 40', 112'  
 (length) (depth to top)  
12", stainless steel  
 (size) (material)
- (6) pump \_\_\_\_\_ (HP) \_\_\_\_\_ (yield gpm)

No other information available.  
 (type power)

- (7) electric log no  
 (yes or no)  
 (organization running log)
- (8) how well bottom plugged plate

DRILLERS REMARKS:

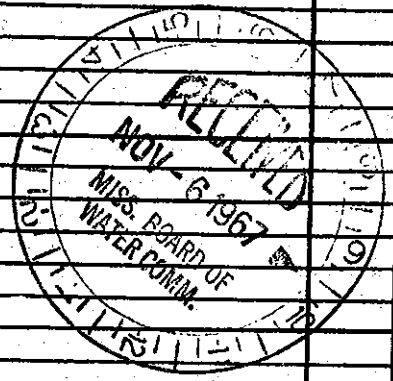

**CODED**

**CODED**