

Bolivar
S 30
11-67

MISSISSIPPI
 BOARD OF WATER COMMISSIONERS
 416 North State Street
 Jackson, Mississippi 39201

CODED

WATER WELL DRILLERS LOG

11/21 1967 Fulton Well Supply Co Bolivar
 date well completed firm name county well located

LANDOWNER:

description of formations encountered

from to

J. F. Brown
R. F. D. Shaw mrs.
 (mailing address)

<u>Top clay</u>	<u>100</u>	<u>15</u>
<u>Fine sand</u>	<u>15</u>	<u>20</u>
<u>Coarse li</u>	<u>25</u>	<u>30</u>
<u>Sand & gravel</u>	<u>50</u>	<u>130</u>
<u>Clay</u>	<u>130</u>	<u>150</u>
<u>Sand & fine</u>	<u>150</u>	<u>165</u>
<u>Shale & clay</u>	<u>165</u>	<u>270</u>
<u>Fine sand</u>	<u>270</u>	<u>340</u>
<u>Shale & clay</u>	<u>340</u>	<u>530</u>
<u>Fine sand</u>	<u>530</u>	<u>570</u>
<u>Shale</u>	<u>570</u>	<u>580</u>
<u>good sand</u>	<u>580</u>	<u>625</u>

WELL LOCATION:


sec. 11 T. 20 N R. 7 E
6 miles west of Shaw
 (distance) (direction) (nearest town)

WELL PURPOSE: Home
 (home, irrigation, municipal, industrial)

WELL COMPLETION DATA:

- (1) diameter (inches) 4x2
- (2) total depth (feet) 620 ft
- (3) static water level (feet) 24 below above top of ground.
- (4) casing gal pipe 100
 (material) (depth)
 if telescope see back.
 (size)
- (5) screen 20 600
 (length) (depth to top)
2 Stainless steel
 (size) (material)
- (6) pump 1 35
 (HP) (yield gpm)
elec
 (type power)
- (7) electric log _____
 (yes or no)
 (organization running log)
- (8) how well bottom plugged B.P.V.

CODED

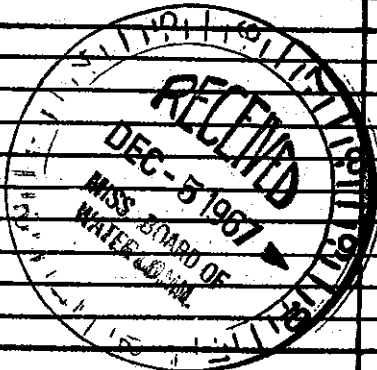

DRILLERS REMARKS: