

BOLIVAR
563
3-6-81

MISSISSIPPI DEPARTMENT OF NATURAL RESOURCES
 Bureau of Land and Water Resources
 Southport Mall
 P.O. Box 10631
 Jackson, Mississippi
WATER WELL DRILLER

127
CODED

3/6 19**81** **Dyll** **Bolivar**
 date well completed firm name county well located


LANDOWNER:
PURVIS RICHARD
 (mailing address)
WELL LOCATION:
 sec **24** T **20N** R **7** E
4 miles **W** of **Choctaw**
 (distance) (direction) (nearest town)

description of formations encountered	from	to
Clay	23	33
Sand	33	43
Loam	43	53
sand granite	53	63
loam granite	63	73
gravel	73	83
gravel	83	93
gravel	93	103
gravel	103	110

WELL PURPOSE:
 (home, irrigation, municipal, industrial)

WELL COMPLETION DATA:
 (1) diameter (inches) **16"**
 (2) total depth (feet) **110'**
 (3) static water level (feet) **23'** below top of ground
 (4) casing **Steel** **110'**
 (material) (depth)
16" if telescope see back.
 (size)
 (5) screen **40'** **70'**
 (length) (depth to top)
16" **Steel**
 (size) (material)
 (6) pump **60** **3000**
 (HP) (yield gpm)
electric
 (type power)
 (7) electric log _____
 (yes or no)
 (organization running log)
 (8) how well bottom plugged **plate**

CODED

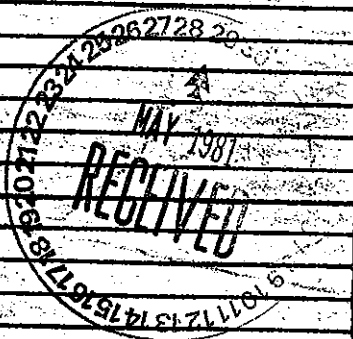

DRILLERS REMARKS: