

MS-GW-08086
 595

MISSISSIPPI DEPARTMENT OF NATURAL RESOURCES
 Bureau of Land and Water Resources
 Southport Mall
 P.O. Box 10631
 Jackson, Mississippi 39209
WATER WELL DRILLERS LOG

date well completed 1988 Dyer Well Bolivar
 firm name county well located


LANDOWNER: Travis Satterfield
 Rt. 1 Box 70
 Shaw, Ms. 38725
 (mailing address)

description of formations encountered	from to	
	feet	feet
Clay	0	28
fine sand	28	40
M Sand + Gravel	40	48
Sand + Gravel	48	68
M Sand + Gravel	68	75
Sand + Gravel	75	105

WELL LOCATION:
 sec. 1 T. 20 N. R. 7 W. S. 10
 10 miles W of Shaw
 (distance) (direction) (nearest town)

WELL PURPOSE: Irrigation
 (home, irrigation, municipal, industrial)

- WELL COMPLETION DATA:
- (1) diameter (inches) 16"
 - (2) total depth (feet) 105'
 - (3) static water level (feet) _____ below/above top of ground.
 - (4) casing steel (material), (depth) 16" (size) if telescope see back.
 - (5) screen 40' (length), (depth to top) 16' (size), (material)
 - (6) pump 60 (HP), (yield gpm) Gear (type power)
 - (7) electric log No (yes or no)
 None (organization running log)
 - (8) how well bottom plugged Plate

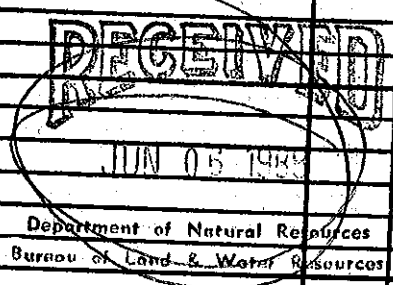

DRILLERS REMARKS: