| • | State W | all Danort | |
|-----------------------------------------------------------------------------------|------------------------------|----------------------------------|-----------------------------------|
| Polivor | State Well Report Part 1 | | For Office Use Only: |
| County: Bolivar | | t of Environmental Quality | Aquifer: |
| Permit # (0 W 4102) | | nd Water Resources | Well #: 5-119 |
| Irrigation Equipment | | 30x 10631 | |
| Date drilling completed: 4-20-06 | Jackson, M | IS 39289-0631 961-5210 | L. S. Elevation: |
| Date drilling completed: | (601)354 | 4-6938 (fax) | E-log #: |
| | . , | | 4.7.12 |
| State Law requires that this rep | | driller in detail and filed w | ith the Department within |
| 30 days of completion of drilling Well Owner Informa | or the well. | Wel | Location |
| | | | 5, 90, 53, 15.0 |
| Owner Name Richard Farms | | Latitude: | 5 Longitude: 90, 53, 15.0 |
| Mailing Address: 1925 Hwy. 450 Method of Lat/ | | Method of Lat/Long (circle or | ne): Conventional Survey, |
| | | USGS quad, Hand-held | GPS, Survey-grade GPS |
| | | NE 1/2 Sec 26 | Twn 20N Rng 7W |
| Greenville MS 38703 | | | |
| City Star 662-754-434 | te Zip Code | Distance Direction 5 Miles West | Nearest Town of Choctaw |
| Telephone No. () | - | - Ivinos 11000 | 01 |
| | | | |
| | Well 1 | Data | |
| Purpose of Well (circle one) Home Ind | ustrial Public Supply | Irrigation Fish Culture | Other: |
| Date well drilling started: | 20-06 Date v | well drilling completed: | 1-20-06 |
| If flowing, method of flow regulation: Val | lve Other (d | lescribe) | |
| Static Water Level: 32 feet at | pove or below/(circle one) l | and surface Date measured: | 4-28-06 |
| Method of Measurement (circle one) | teel tape electric tape | air line other: | |
| Hole depth: 120 Well de | pth: <u>120 '</u> | Well grouted to a depth of _ | 1 0feet |
| Type of grout (circle one): Cement | Bentonite Mix | | |
| | ng diameter: 16 | inches Type of casing: _ | PVC Sch.40 |
| Screen length: 40 feet Scre | en diameter: 16 | inches Type of screen: | PVC Sch.40 |
| Screen slot size: . 050 inches | Setting depth: From _ | 81 feet to <u>1</u> | 20 feet |
| Type of completion (circle all applicable): | Gravel packed Under | reamed Telescoped Oper | hole Natural Development |
| | Other (describe): | | |
| Top of lap pipe or reduction in casing: | feet. If te | lescoped or more than one sci | een, describe on back of page |
| Logs run (circle all applicable): No log ru | n) Electric Gamma Ray | Density Sonic Neutron | Other: |
| Name of organization running log(s): I certify that the well was drilled, constr | ucted, and completed in | accordance with all applicable | e requirements of the Mississippi |

Department of Environmental Quality and/or the Mississippi Department of Health regulations and state laws.

0695

Irrigation Equipment Inc.

Patrick M. Chism

Print Name of Water Well Contractor and License No.

RECEIVED

Signature of Water Well Contractor

MAY 0 8 2006


BY: OLWR

5: ,

Ground Level

| Description of Formations Encountered | From | To |
|---------------------------------------|--------------------------------------------------|--------------------------------------------------|
| Clay | 0 | 19 |
| Fine Sand | 20 | 25 |
| Fine Sand/gravel | 26 | 35 |
| Med. Sand | 36 | 45 |
| Med. Sand/gravel | 46 | 120 |
| | | لـــــا |
| | | |
| | | |
| | i | |
| | | |
| | | |
| | | |
| | | $\vdash \vdash \vdash$ |
| | | \vdash |
| | | \vdash |
| | - | |
| | | 1 |
| | | - |
| | ┼— | - |
| | <u> </u> | |
| | | <u></u> |

If more than one screen, show location of each on sketch

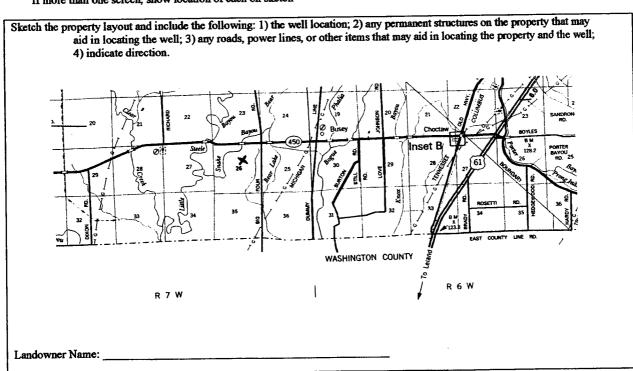

Watur M Chi

STATE WELL REPORT

County: Bolivar Permit #: GW 410 21 Irrigation Equipment Driller: 4-20-06

Copy information from block on Part 1

Part 2
Pump Installer's Completion Report
Mississippi Department of Environmental Quality
Office of Land and Water Resources
P.O. Box 10631
Jackson MS 39289-0631

P.O. Box 10631 Jackson, MS 39289-0631 (601)961-5210 (601)354-6938 (fax)

| For Office Use Only: | | |
|----------------------|--|--|
| Aquifer: | | |
| well #: 5-119 | | |
| Elevation: | | |

| Well Owner Information | at the above address within 30 days of well completion. Well Location | |
|--------------------------------------------------|------------------------------------------------------------------------|--|
| Owner Name: Richard Farms | Latitude: Longitude: | |
| Mailing Address: 1925 Hwy. 450 | Method of Lat/Long (check one): Conventional Survey, | |
| | USGS quad, Hand-held GPS, Survey-grade GPS | |
| Greenville MS 38703 | SW $_{4}$ NE $_{4}$ Sec 26 $_{T}$ 20N $_{R}$ 7W | |
| City State Zip Code | | |
| 662-754-4342 | Distance Direction Nearest Town | |
| Telephone No. () | 5 West Choctaw of | |
| Pump Type Circle one | Power Type Circle one | |
| Air Lift Jet Submersible | Diesel Engine Gasoline Engine Natural Gas | |
| Bucket Piston Turbine | Electric Motor Hand Tractor PTO | |
| Centrifugal Rotary Flowing Well | Windmill Other (specify): | |
| Other (specify): | Horse Power Rating of Motor. 60 | |
| Date Pump Installed: 4-28-06 | Setting Depth: 70 feet | |
| Rated Pump Capacity: 2500-300 Gallons Per Minute | Number of Stages: 1 | |
| Pump Test Data | Method of Measuring Water Level | |
| Date Well Tested: | Circle one | |
| Static Water Level (A):Feet Below Land Surface | Air Line Electric Measuring Line Steel Tape | |
| Pumping Water Level (B):Feet Below Land Surface | Other (specify): | |
| Drawdown [(B) - (A)]:Feet Below Land Surface | For flowing well, measured shut in head:feet | |
| Test Pumping Rate:Gallons Per Minute | Well yieldedGPM with a drawdown of | |
| Duration of Pump Test (minimum 4 hours):hours | feet afterhours of pumping | |

| I HEREBY CERTIFY that the above statements are true to the bes | t of my knowlestige/ | |
|----------------------------------------------------------------|-----------------------------|--|
| Patrick M. Chism 0695 | Patul M Chi | |
| Print Name of Pump Installer and License No. (if applicable) | Signature of Pump Installer | |

Form: OLWR-SWR-1B

RECEIVED

MAY 0 8 2006

BY: OLWR