

DEC-06-2007 10:18 From: MID SOUTH WATER

6628431717

To: 601 360 0535

P.2/3

739

(2)

County: Bolivar
 Permit #: GW42287
 Driller: Ronnie Dill
 Date drilling completed: 12-1-07

State Well Report
Part I - Driller's Log

Mississippi Department of Environmental Quality
 Office of Land and Water Resources
 P.O. Box 10631
 Jackson, MS 39289-0631
 (601)961-5210
 (601)354-6938 (fax)

For Office Use Only:
 Aquifer:
 Well #: 7793
 L.S. Elevation: 5151
 Log #:

State Law requires that this report be prepared by the license holder responsible for the work and filed with the Department at the above address within 30 days of completion of drilling of the well or borehole.

Information on Well Owner <i>(Landowner if borehole is not for a water well)</i>	Well or Borehole Location
Owner Name: <u>Hi H Farms</u>	Latitude: <u>N 33° 35' 46.5"</u> Longitude: <u>W 88° 57' 02.2"</u>
Mailing Address: <u>P.O. Box 118</u>	Method of Lat/Long (circle one): <u>Hand-held GPS</u> Conventional Survey
<u>Benoit</u> MS <u>39725</u>	USGS quad: <u> </u> Survey-grade GPS
City State Zip Code	NW 1/4 NW: Sec <u>18</u> Twn <u>20N</u> Rng <u>1W</u>
Telephone No. <u>(662) 742-3335</u>	Distance <u>5</u> Miles Direction <u>West</u> of Nearest Town <u>Shaw</u>

Well / Borehole Data

Date drilling started: 12-1-07 Date drilling completed: 12-1-07 Hole depth: 115' Hole diameter: 26"

Location of the source of any surface water used for drilling: CANAL

Method of dosing and volume of Chlorine used in drilling and development: 2 LBS CE 2

Logs run (circle all applicable): (No log run) Electric Gamma Ray Density Sonic Neutron Other:

Name of organization running log(s):

Purpose of borehole (check one): Water Well Geotechnical/Geological Investigation Ground Source Heat Pump Seismic Survey Other (describe)

If drilling is not related to water well construction, skip the remainder of this block

Purpose of Well (check one): Home Industrial Public Supply Irrigation Fish Culture Other:

If a flowing well, method of flow regulation: Valve Other (describe) Replaced 7919

Static Water Level: 20 feet above or (below circle one) land surface Date measured: 12/5/07

Method of Measurement (circle one) steel tape electric tape air line other:

Well depth: 110 Well grouted to a depth of 10 feet Type of grout (circle one) Neat Cement Bentonite Mix

Casing length: 70 feet Casing diameter: 16 inches Type of casing: PVC

Screen length: 40 feet Screen diameter: 16 inches Type of screen: PVC

Screen slot size: .050 inches Setting depth: From 70 feet to 110 feet

Type of completion (circle all applicable): (Gravel packed) Underreamed Telescoped Open hole Natural Development

Other (describe):

Top of lap pipe or reduction in casing: feet. *If telescoped or more than one screen, describe on next page*

Form OLWR-SWR-1A

"Replacement Wells"
 GW07919

RECEIVED
 DEC 06 2007
 BY: OLWR

DEC-06-2007 10:18 From: MID SOUTH WATER 6628431717 To: 601 360 0535 P.3/3 5151


GW42287

195

The sketch below only required for water wells.

Description of formations encountered must be provided for all wells and boroholes, unless specifically exempted by regulations


If well telescopes, show depths on sketch.

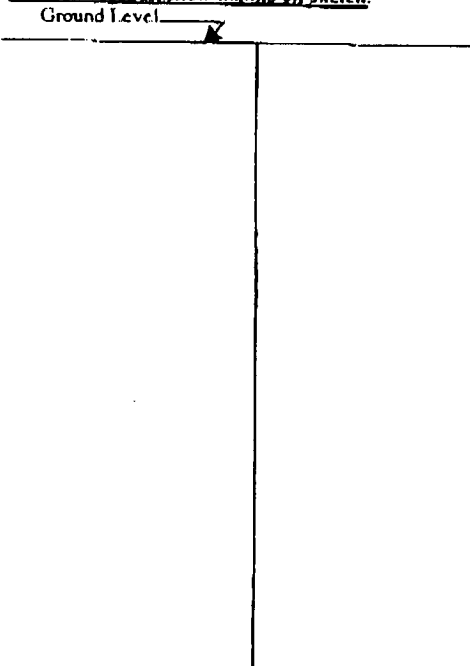

Description of Formations Encountered	From (depth)	To (depth)
Top Soil	Ground Level	15
Clay & Sand	15	25
Coarse Sand	25	35
Coarse Sand	35	45
Coarse Sand	45	55
Coarse Sand	55	65
Coarse Sand & Gravel	65	75
Coarse Sand & Gravel	75	85
Coarse Sand & Gravel	85	95
Coarse Sand & Gravel	95	105
Coarse Sand & Gravel	105	115

If more than one screen, show location of each on sketch

Sketch the property layout and include the following: 1) the well location; 2) any permanent structures on the property that may aid in locating the well; 3) any roads, power lines, or other items that may aid in locating the property and the well; 4) a north arrow.

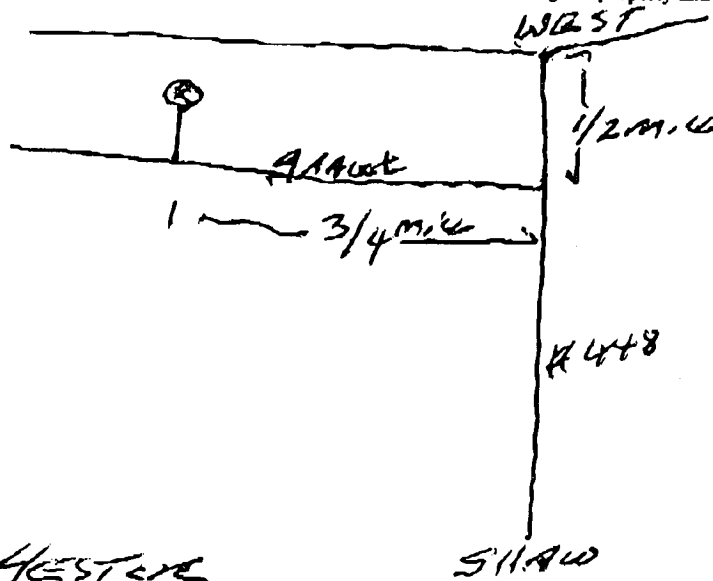

Landowner Name: ED HESTER

I certify that the well/borehole was drilled, constructed, and completed in accordance with all applicable requirements of the Mississippi Department of Environmental Quality and the Mississippi Department of Health regulations, if applicable, and state laws.

Print Name of Responsible Licensee and License No. Thomas G. Christman D-703

Date 12/6/07 Signature of Licensee Thomas Christman

Form: OLWR-SWR-1A
RECEIVED

DEC 06 2007

BY: OLWR