

10" WELL

STATE WELL REPORT

130

County: BOLIVAR
 Permit #: GW-51123
 Driller: JOHN NEWCOME
 Date drilling completed: 3-3-20

**Part 1
 Driller's Log**
 Mississippi Department of Environmental Quality
 Office of Land and Water Resources
 P.O. Box 2309
 Jackson, MS 39225-2309
 (601)961-5555
 (601)961-5228 (fax)

For Office Use Only:
 Well #: S 184
 Aquifer: _____
 E-Log #: _____

State Law requires that this report be prepared by the license holder responsible for the work and filed with the Department at the above address within 30 days of completion of drilling of the well or borehole.

Well Owner Information <i>(Landowner if borehole is not for a water well)</i>	Well or Borehole Location
Owner Name: <u>WILLIAM A. HESTER, JR.</u>	Latitude: <u>33°35'06.9</u> Longitude: <u>090° 57' 12.8"</u>
Mailing Address: <u>225 WARDEN RD. E.</u>	Method of Lat/Long (check one): Conventional Survey _____, USGS quad _____, Hand-held GPS _____, Survey-grade GPS _____
<u>GREENVILLE, MS 38701</u>	<u>NE 1/4 NE 1/4, Sec 18 T 20 N R 7 W</u>
City State Zip Code	<u>5 1/2</u> Miles <u>SE</u> of <u>BENOIT, MISS</u>
Telephone No. <u>(662) 820-4026</u>	(Distance) (Direction) (Nearest Town)

Well / Borehole Data

Date drilling started: 3-3-20 Date drilling completed: 3-3-20 Hole depth: 118' Hole diameter: 20

Location of the source of any surface water used for drilling: DITCH

Method of dosing and volume of Chlorine used in drilling and development: TABLETS (CHLORINE)

Logs run (check all applicable): log run Electric Gamma Ray Density Sonic Neutron Other: _____

Name of organization running log(s): -

Purpose of borehole (check one): Water Well Geotechnical/Geological Investigation Ground Source Heat Pump Seismic Survey Other (describe) _____

If drilling is not related to water well construction, skip the remainder of this block

Purpose of Well (check all applicable): Home Industrial Public Supply Irrigation Fish Culture

Other (describe): _____

If a flowing well, method of flow regulation: Valve _____ Other (describe) _____

Static Water Level: _____ feet above or below land surface Date measured: _____
 (check one)

Method of measurement (check one) Steel tape Electric tape Air line Other (describe): _____

Well depth: 110 Well grouted to a depth of: 10 feet Type of grout (check one) Neat Cement Bentonite Mix

Casing length: 85 feet Casing diameter: 10 inches Type of casing: PVC

Screen length: 25 feet Screen diameter: 10 inches Type of screen: PVC

Screen slot size: .050 inches Setting depth: From _____ feet to _____ feet

Type of completion (check all applicable) gravel packed Underreamed Open hole Natural Development

Other (describe): _____

Top of lap pipe or reduction in casing: _____ feet


If telescoped or more than one screen, describe on next page

RECEIVED
 MAR 12 2020
 BY OLWR

County: BOLIVAR
 Permit #: _____

For Office Use Only:
 Well #: _____

The sketch below only required for water wells
If well telescopes, show depths on sketch.

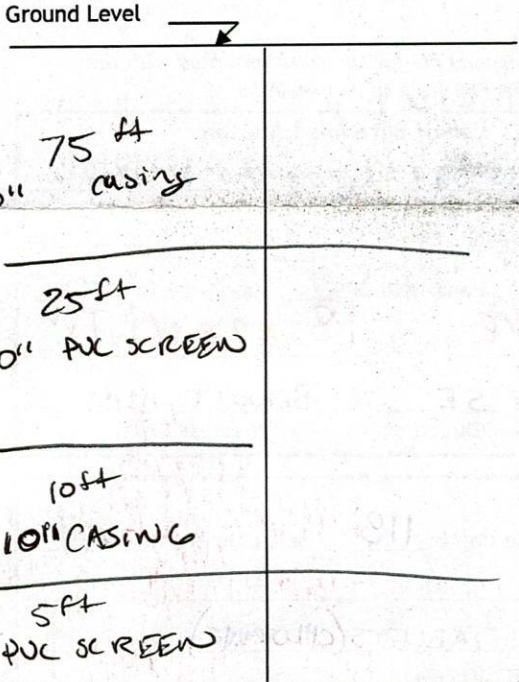

If more than one screen, show location of each on sketch

Description of formations encountered must be provided for all wells and boreholes, unless specifically exempted by regulations

Description of Formations Encountered	From (depth)	To (depth)
TOPSOIL	Ground level	10
CLAY	10	45
PINE SAND	45	75
MEDIUM SAND	75	110
GREY CLAY BOTTOM	110	113

- Sketch the property layout and include the following:
- 1) the well location
 - 2) any permanent structures on the property that may aid in locating the well
 - 3) any roads, power lines, or other items that may aid in locating the property and the well
 - 4) north arrow

SEE ATTACHED MAP

Landowner Name: _____

I HEREBY CERTIFY that the well/borehole was drilled, constructed, and completed in accordance with all applicable requirements of the Mississippi Department of Environmental Quality and the Mississippi Department of Health regulations, if applicable, and state laws.

JOHN NEWCOME 0-773 2-3-20 John Newcome
 Print Name of Responsible Licensee and License No. Date Signature of Licensee

BILL HESTER

10" WELL

Crappeland

448

Stringtown

Stringtown Rd

Legend

- HESTER 10" WELL
- 📍 N33 35 06.9 W090 57 12.8

N33 35 06.9 W090 57 12.8 CHESTER 10" WELL

RECEIVED
MAR 12 2020
BY OLWR



1 mi

Google Earth

© 2020 Google