

**BOLIVAR** MISSISSIPPI BOARD OF WATER COMMISSIONERS

S-1004  
9-3-57

**WATER WELL DRILLERS LOG**

2338

Date: Sept. 3, 19 57, Driller: Layne-Central Company County Bolivar

(Name)

(1) Owner of Land: Kemp Whisenhunt

(Name)

Blytheville, Arkansas

(Address)

(2) Location: 1/4, 1/4, Sec.     T     R    

7 miles west of Shaw  
(distance) (direction) (Nearest Town)

(3) Topography: flat  
(Hilly) (Flat) (Level)

(4) Purpose of Well: irrigation

(Domestic Irrigation  
Municipal, Industrial, Other)

Information upon completion of well:

- (1) Diameter 16x12 inches.
- (2) Total Depth 112 feet.
- (3) Water Level 16'-7" feet below top of ground.
- (4) Cased to 57', Size 16"  
2' swage.
- (5) Screen: Size 12", Length 50"  
3' of 12" blank
- (6) Were any formations sealed against pollution?  
    yes, no no.

If YES depth of formation    

Why    


Drillers Remarks:    

1599 GPM

electric power

Mail this copy  
retain this copy for your office files.

Description & Color of Materials Sand, Clay, Red Clay, Shell, etc.	Thick- ness Feet	Depth Feet
Clay	25	25
Fine sand	21	46
Coarse sand	18	64
Medium sand	16	80
Coarse sand	5	85
Medium sand	14	99
Coarse sand, big gravel	13	112
Clay bottom		112

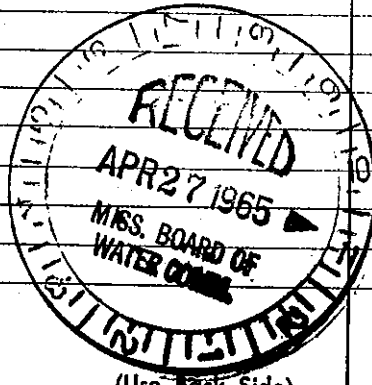

(Use Back Side)

Well No.