

BOLIVAR

MISSISSIPPI BOARD OF WATER COMMISSIONERS

T 25

WATER WELL DRILLERS

CODED

7-27-64

Date: 7/27, 1964, Driller: Delta Well Supply Co County Bolivar

(Name)

(1) Owner of Land:	Description & Color of Materials Sand, Clay, Red Clay, Shell, etc.	Thick- ness Feet	Depth Feet
J.H. Arritt Jr. (Name)	Top soil Sand	10	
Shaw Miss. (Address)	Fine sand & Clay	36	46
(2) Location: 1/4, 1/4, Sec. 2, T20R6	Fine to coarse sand	102	148
2 miles No. West of Shaw (distance) (direction) (Nearest Town)	Clay	88	236
(3) Topography: <input checked="" type="checkbox"/> (Hilly) <input type="checkbox"/> (Flat) <input type="checkbox"/> (Level)	sandy	134	370
(4) Purpose of Well: Domestic (Domestic Irrigation, Municipal, Industrial, Other)	Shale clay, sand break	422	792
	Rock	1	793
	Shale	82	875
	Sand Fine	53	930
	" Med.	27	957

Information upon completion of well:


- (1) Diameter 4 1/2 inches.
- (2) Total Depth 957 feet.
- (3) Water Level 22 feet below ground.
- (4) Cased to _____, Size _____
- (5) Screen: Size 2", Length 20 ft.
- (6) Were any formations sealed against pollution?
_____ yes, _____ no.

CODED

If YES depth of formation _____

Why _____

Drillers Remarks: _____

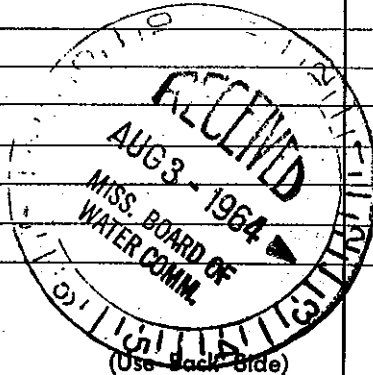

Well No.

Mail this copy to Board of Water Commissioners 429 Miss. St. Jackson, Miss.