

BOLIVAR MISSISSIPPI BOARD OF WATER COMMISSIONERS

T 27

8-7-65

WATER WELL DRILLERS LOG

CODED


Date: 8/7, 1965, Driller: Bailey Drilling Co. County: Washington
(Name)

(1) Owner of Land:	Description & Color of Materials Sand, Clay, Red Clay, Shell, etc.	Thick- ness Feet	Depth Feet
<u>Hegar Proo</u> (Name) <u>Shaw</u> (Address)	<u>Clay</u>		<u>20</u>
(2) Location: <u>1/4</u> , <u>1/4</u> , Sec. <u>19</u> T. <u>20</u> R. <u>6</u> miles <u>SW</u> of <u>Shaw</u> (distance) (direction) (Nearest Town)	<u>Sand</u>		<u>100</u>
(3) Topography: <u>Flat</u> (Hilly) (Flat) (Level) <u>r</u>	<u>Gravel</u>		<u>140</u>
(4) Purpose of Well: <u>Domestic</u> (Domestic Irrigation Municipal, Industrial, Other)	<u>Mud</u>		<u>330</u>
	<u>Rock</u>		<u>331</u>
	<u>Mud</u>		<u>420</u>
	<u>Sand</u>		<u>466</u>

Information upon completion of well:

- (1) Diameter 4 x 7 inches.
- (2) Total Depth 466 feet.
- (3) Water Level 17 feet below top of ground.
- (4) Cased to all way Size _____
- (5) Screen: Size 2", Length 20ft.
- (6) Were any formations sealed against pollution?
_____ yes, X no.

CODED

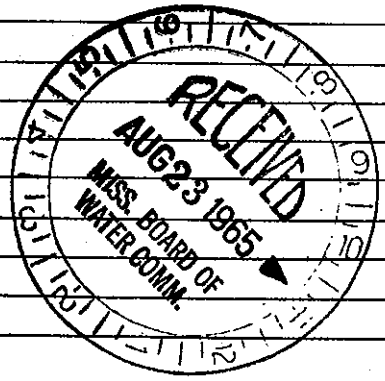

If YES depth of formation _____
Why _____
Drillers Remarks: _____

(Use Back Side)

Well No. _____

Mail this copy to Board of Water Commissioners 429 Miss. St. Jackson, Miss.