

BOLIVAR MISSISSIPPI BOARD OF WATER COMMISSIONERS

T 53

5-8-63

WATER WELL DRILLERS LOG

5/63/63
1545

Date: May 8, 1963, Driller: Layne-Central Company County Bolivar

(Name)

	Description & Color of Materials Sand, Clay, Red Clay, Shell, etc.	Thick- ness Feet	Depth Feet
(1) Owner of Land: <u>Dan Seligman</u> (Name)	Clay	23	23
<u>Shaw, Mississippi</u> (Address)	Coarse sand	25	48
(2) Location: <u>T20N</u> <u>R6W</u> <u>1/4</u> , <u>1/4</u> , Sec. <u>22</u> T. <u>20N</u> R. <u>6W</u>	Coarse sand, pea gravel	27	75
<u>1/4</u> miles <u>south</u> of <u>Shaw</u> (distance) (direction) (Nearest Town)	Lignite & gravel	10	85
(3) Topography: <u>flat</u> (Hilly) (Flat) (Level)	Pea gravel	10	95
(4) Purpose of Well: <u>irrigation</u> (Domestic Irrigation Municipal, Industrial, Other)	Big boulders	7	102


Information upon completion of well:

- (1) Diameter 16 inches.
- (2) Total Depth 102' feet.
- (3) Water Level 16'-7" feet below top of ground.
- (4) Cased to 52', Size 16"
- (5) Screen: Size 16", Length 50'
- (6) Were any formations sealed against pollution?
no yes, no no.

If YES depth of formation _____

Why _____

Drillers Remarks: _____

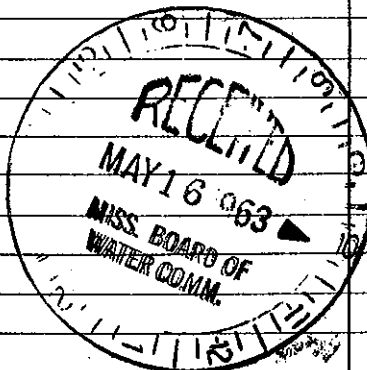

(Use Back Side)

Well No.

Mail this copy to Board of Water Commissioners 429 Miss. St. Jackson, Mis