

MISSISSIPPI BOARD OF WATER COMMISSIONERS

WATER WELL DRILLERS LOG

*Bolivar*  
*PT 83*  
*3-67*

Date: 3-20-67, 19  , Driller: Dyer Well & Irrigation County Bolivar

(Name)  
**Well # 3**

(1) Owner of Land: Dan Seligman  
(Name)  
Shaw, Miss.  
(Address)

(2) Location: SW 1/4, NW 1/4, Sec. 33 T.20 R.4  
20 6  
5 1/2 miles N.W., of Shaw  
(distance) (direction) (Nearest Town)

(3) Topography: Flat  
(Hilly) (Flat) (Level)

(4) Purpose of Well: Irrigation  
(Domestic Irrigation  
Municipal, Industrial, Other)

Description & Color of Materials Sand, Clay, Red Clay, Shell, etc.	Thick- ness Feet	Depth Feet
0 - 13 Clay		
13 - 23 "		
23 - 33 Blue Mud		
33 - 43 " " & Fine Sand		
43 - 53 Coarse Sand and Gravel		
53 - 63 " " " "		
63 - 73 " " " "		
73 - 83 " " " "		
83 - 93 " " " "		
93 - <del>103</del> " " " "		
103 - 113 <del>103</del> " " " "		

Information upon completion of well:

(1) Diameter 16 inches.

(2) Total Depth 107 feet.


(3) Water Level 18 feet below top of ground.

(4) Cased to 67', Size 16 inch

(5) Screen: Size 16 Inch, Length 40'

(6) Were any formations sealed against pollution?  
   yes, X no.

**CODED**

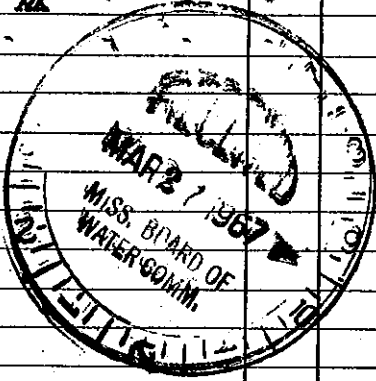

If YES depth of formation \_\_\_\_\_

Why \_\_\_\_\_

Drillers Remarks: None

Well No.

(Use Back Side)

Mail this copy to Board of Water Commissioners 429 Miss. St. Jackson, Miss.