

Bolivar MISSISSIPPI BOARD OF WATER COMMISSIONERS

T 27  
6-66

WATER WELL DRILLERS LOG

CODED  
Bolivar

Date: June 3, 1966, Driller: Butane Gas Co. County: ~~Leflore~~

(Name)

(1) Owner of land: <u>J. H. Avritt</u> (Name)	Description & Color of Materials Sand, Clay, Red Clay, Shell, etc.	Thick- ness Feet	Depth Feet
<u>Shaw, Miss.</u> (Address)	Clay	13	13
	Fine sand	10	23
(2) Location: <u>SW 1/4, NE 1/4, Sec. 10, T4N, R10W</u>	" "	10	33
<u>2</u> miles <u>West</u> of <u>Shaw</u>	" "	10	43
(distance) (direction) (Nearest Town)	" "	10	53
(3) Topography: <u>Flat</u>	Coarse sand & gravel	10	73
(Hilly) (Flat) (Level)	" " "	10	83
(4) Purpose of Well: <u>Irrigation</u>	" " "	10	93
(Domestic Irrigation Municipal, Industrial, Other)	" " "	10	103


Information upon completion of well:

- (1) Diameter 12 inches.
- (2) Total Depth 103 feet.
- (3) Water Level 15 feet below top of ground.
- (4) Cased to 63, Size 12
- (5) Screen: Size 12, Length 40
- (6) Were any formations sealed against pollution?  
 yes,  no.

If YES depth of formation \_\_\_\_\_

Why \_\_\_\_\_

Drillers Remarks: \_\_\_\_\_

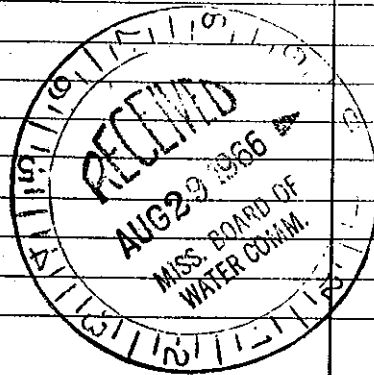

(Use Back Side)

Well No.

Retain this copy for your office files.