

Boliver

MISSISSIPPI BOARD OF WATER COMMISSIONERS

T 88
8-13-66

WATER WELL DRILLERS LOG

Date: 8/15, 1966, Drilled by Delta Well Supply Co., Bolivar
(Name)

(1) Owner of Land	Description & Color of Materials Sand, Clay, Red Clay, Shell, etc.	Thick- ness Feet	Depth Feet
Lee Ferritti (Name) Shaw (Address)	Top soil clay	22	
(2) Location: SW 1/4, Sec. 4 T. 20 N. R. 6 W.	Fine sand	33	55
3 miles West of Shaw (distance) (direction) (Nearest Town)	Coarse sand & gravel	71	126
(3) Topography: (Hilly) (Flat) (Level)	Cased		
(4) Purpose of Well: Irrigation (Domestic Irrigation, Municipal, Industrial, Other)			


Information upon completion of well:

- (1) Diameter 10 inches.
- (2) Total Depth 126 feet.
- (3) Water Level 21 feet below top of ground.
- (4) Cased to 96, Size 10
- (5) Screen: Size 10, Length 30
- (6) Were any formations sealed against pollution?
yes, no.

If YES depth of formation

Why

Drillers Remarks:

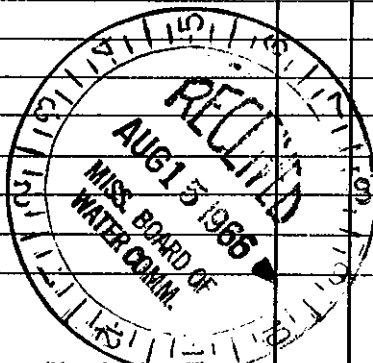

(Use Back Side)

Well No.

Mail this copy to Board of Water Commissioners 429 Miss. St. Jackson, Mis.