

Bolivar  
T 90  
3-67

MISSISSIPPI BOARD OF WATER COMMISSIONERS

WATER WELL DRILLERS LOG

Date: 3-14-67, 19  , Driller: Dyer Well & Irrigation County Bolivar

(Name) Well# 2

(1) Owner of Land: Dan Seligman  
(Name)  
Shaw, Miss.  
(Address)

(2) Location: NW 1/4, SE 1/4, Sec. 5 T29 R26  
5 miles West, of Shaw  
(distance) (direction) (Nearest Town)

(3) Topography: Flat  
(Hilly) (Flat) (Level)

(4) Purpose of Well: Irrigation  
(Domestic Irrigation  
Municipal, Industrial, Other)

Description & Color of Materials Sand, Clay, Red Clay, Shell, etc.	Thick- ness Feet	Depth Feet
0-13 Clay		
13-23 "		
23-33 "		
33-43 Fine Sand		
43-53 " "		
53-63 Med Sand		
63-73 Coarse Sand & Gravel		
73-83 " "		
83-93 " "		
93-103 " "		

Information upon completion of well:

(1) Diameter 16 inches.

(2) Total Depth 93 feet.

(3) Water Level 18 feet below top of ground.

(4) Cased to 53', Size 16 inch.

(5) Screen: Size 16, Length 40'.

(6) Were any formations sealed against pollution?  
   yes, X no.


CODED

CODED

If YES depth of formation \_\_\_\_\_

Why \_\_\_\_\_

Drillers Remarks: None

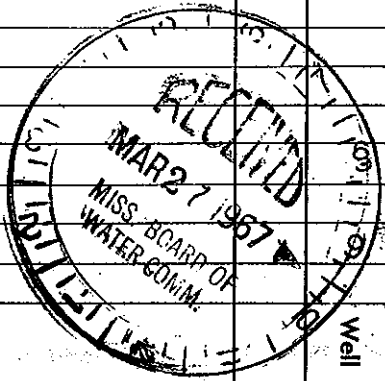

(Use Back Side)

Well No.

Mail this copy to Board of Water Commissioners 429 Miss. St. Jackson, Miss.