

BOLIVAR
T 93
3-68

MISSISSIPPI
 BOARD OF WATER COMMISSIONERS
 416 North State Street
 Jackson, Mississippi 39201

CODED

WATER WELL DRILLERS LOG

3-6 1968 DYER WELL & IRR. BOLIVAR
 date well completed firm name county well located

LANDOWNER: DAN SELIGMAN
 SHAW
 miss.
 (mailing address)


description of formations encountered	from	to
CLAY	0	15
FINE SAND	15	34
COARSE SAND	34	44
MED. SAND	34	63
COARSE SAND + GRAVEL	63	108

WELL LOCATION:
 sec. 4 T20 N R. 6 E
 3 miles W of SHAW
 (distance) (direction) (nearest town)

WELL PURPOSE: IRR.
 (home, irrigation, municipal, industrial)

- WELL COMPLETION DATA:
- (1) diameter (inches) 16"
 - (2) total depth (feet) 107'
 - (3) static water level (feet) 20' below above top of ground.
 - (4) casing BLU. IR. 67'
 (material) (depth)
16 If telescope see back.
 (size)
 - (5) screen 40 FT. 67'
 (length) (depth to top)
16" BLU. IRON
 (size) (material)
 - (6) pump 33 1800
 (HP) (yield gpm)
DIESEL
 (type power)
 - (7) electric log No
 (yes or no)
 - (organization running log)
 - (8) how well bottom plugged PLATE

CODED

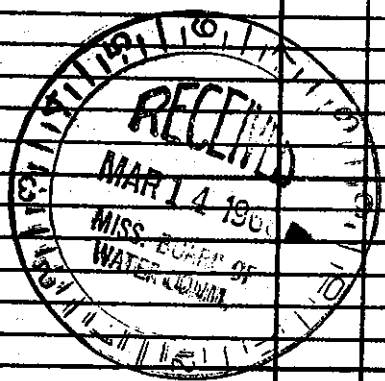

DRILLERS REMARKS: