


BOLIVAR MISSISSIPPI BOARD OF WATER COMMISSIONERS

~~4-4-61~~ ⁹⁶ ~~CODED~~ WATER WELL DRILLERS LOG ~~CODED~~ ³⁰⁰

Date: 4/4, 1961, Driller: Delta Well Supply Co. Bolivar
 (Name)

(1) Owner of Land	Description & Color of Materials Sand, Clay, Red Clay, Shell, etc.	Thick- ness Feet	Depth Feet
<u>Mrs. A. W. Landig</u> (Name) <u>Shene Miss.</u> (Address)	<u>Top soil & Clay</u>	<u>16</u>	<u>16</u>
	<u>Fine sand & breaks</u>	<u>20</u>	<u>36</u>
	<u>" "</u>	<u>22</u>	<u>58</u>
(2) Location: <u>N 1/4, E 1/4, Sec. 6 T4 R6 W4</u> <u>2 1/2</u> miles <u>West</u> of <u>Shene</u> (distance) (direction) (Nearest Town)	<u>Coarse "</u>	<u>18</u>	<u>76</u>
	<u>" " & gravel</u>	<u>49</u>	<u>125</u>
(3) Topography: (Hilly) (Flat) (Level)			
(4) Purpose of Well: <u>Flat</u> (Domestic Irrigation Municipal, Industrial, Other)			
Information upon completion of well:			
(1) Diameter <u>16</u> inches.			
(2) Total Depth <u>125 1/2</u> feet.			
(3) Water Level <u>17</u> feet below top of ground.			
(4) Cased to _____, Size _____			
(5) Screen: Size <u>16</u> , Length <u>41</u>			
(6) Were any formations sealed against pollution? _____ yes, <input checked="" type="checkbox"/> no.			
If YES depth of formation _____			
Why _____			
Drillers Remarks: _____			

CODED

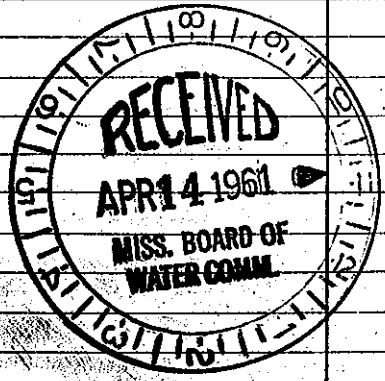

Well No.

(Use Back Side)

Mail this copy to Board of Water Commissioners 429 Miss. St. Jackson, Miss