County:	Boliva	ar
Permit#: (ation E	98/5 quipment
_	g completed:	9-27-04

State Well Report

Part 1

Mississippi Department of Environmental Quality
Office of Land and Water Resources
P.O. Box 10631
Jackson, MS 39289-0631
(601)961-5210
(601)354-6938 (fax)

For Office Use	Only:
Aquifer:	79 011
L. S. Elevation:	
E-log #:	

State Law requires that this report be prepared by the driller in detail and filed with the Department within 30 days of completion of drilling of the well.

So ways of completion of druting of the well.	•		
Well Owner Information	Well Location		
Tri-Cotton Farms Owner Name c/o Steve Skelton	Latitude: 33 34 21N 90 47 54W Longitude: "Longitude: "		
Mailing Address: 85 Hwy. 442	Method of Lat/Long (circle one): Conventional Survey,		
·	USGS quad, Hand-held GPS, Survey-grade GPS		
	1		
Shaw, MS 38773 City State Zip Code	SE 4 SE 4 Sec		
	NW NW Distance Direction Nearest Town		
Telephone No. (662-754-6269	Miles North of Choctaw		
TV. II V			
Well I	~		
Purpose of Well (circle one) Home Industrial Public Supply			
Date well drilling started: 9-27-04 Date w	well drilling completed:		
If flowing, method of flow regulation: Valve Other (d	escribe)		
Static Water Level: 41' feet above or below (circle one) l	and surface Date measured: 9-28-04		
Method of Measurement (circle one) steel tape electric tape	air line other:		
Hole depth: 146 Well depth: 146	Well grouted to a depth of 10 feet		
Type of grout (circle one): Cement Bentonite Mix	·		
Casing length: 86 feet Casing diameter: 16 inches Type of casing: PVC Sch. 40			
Screen length: 60 feet Screen diameter: 16	inches Type of screen: PVC Sch. 40		
Screen slot size: 050 inches Setting depth: From	87feet tofeet		
Type of completion (circle all applicable): Gravel packed Under	reamed Telescoped Open hole Natural Development		
Other (describe):			
Top of lap pipe or reduction in casing:feet. If te	descoped or more than one screen, describe on back of page		
Logs run (circle all applicable): No log run Electric Gamma Ray	Density Sonic Neutron Other:		
Name of organization running log(s):	1		
I certify that the well was drilled, constructed, and completed in a	ccordance with all applicable requirements of the Mississimi		
Department of Environmental Quality and/or the Mississippi Dep			
Irrigation Equipment Inc.			
Patrick M. Chism 0695	Patrick M Chisa		
Print Name of Water Well Contractor and License No.	Signature of Water Well Contractor		

RECEIVED


OCT 1 1 2004

BY: OLWR

Ground	Level

Description of Formations Encountered	From	To
Clay	_0	25
Fine Sand	26	8.5
Med. Sand/gravel	86	146
	<u> </u>	
	<u> </u>	
	<u> </u>	1
	1	
	1	
	<u> </u>	
	<u> </u>	
	-	
	4	
	—	
<u> </u>		
	<u> </u>	
	 	
	 	1
	—	
	 	1
		
		لـــــــــــــــــــــــــــــــــــــ

If more than one screen, show location of each on sketch

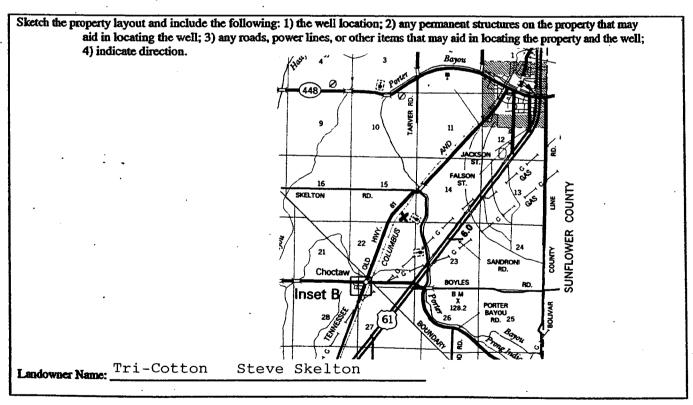

Fatish M Chr.
Signature of Water Well Contractor

STATE WELL REPORT

Part 2

Bolivar County: Permit#: 6W-39815 Irrigation Equipmet

Pump Installer's Completion Report Mississippi Department of Environmental Quality Office of Land and Water Resources P.O. Box 10631

For Office Use Only:	
Aquifer:	
Well #: <u>T-179</u>	
Elevation:	

Driller: Date completed:	9-28-04	Jackson, (60	Jackson, MS 39289-0631 (601)961-5210 (601)354-6938 (fax)		Well #:	
This report shinstallation of		by the pump installer in de	tail and filed with the Depart	ment within 30 d	ays of the	
	Well Owner Info		V	Vell Location		
Owner Name:	Tri-Cotto c/o Steve	n Farms Skelton	Latitude: Longitude:			
Mailing Address: 85 Hwy. 442		Method of Lat/Long (circle one): Conventional Survey,				
			USGS quad, Ha	and-held GPS, Su	rvey-grade GPS	
	Shaw, MS		SE 1/4 SE 1/4 Sec_	5 _{Twn} 20N	Rng 6W	
C	City Sta	nte Zip Code	Distance Direction	Nearest To	NI/M	
662-754-6269 Telephone No. ()		Distance Direction Nearest Town 1 Miles North of Choctaw				
Pump Type Circle one		Power Type Circle one				
Air Lift	Jet	Submersible	Diesel Engine Gaso	dine Engine	Natural Gas	
Bucket	Piston	Turbine	Electric Motor Han	d	Tractor PTO	
Centrifugal	Rotary	Flowing Well	Windmill Oth	er (specify):		
Other (specify):			Horse Power Rating of Mot	tor:75		
Date Pump Installed	9-28-	0 4	Setting Depth:		feet	
	3500_400	Gallons Per Minute	Number of Stages:			
Pump Test Data		Method of Measuring Water Level Circle one				
	A): 41 '1	Feet Below Land Surface	Air Line Electric M Other (specify):	_	Steel Tape	
Drawdown [(B) - (A	A)]:I	Feet Below Land Surface	For flowing well, measured	shut in head:	feet	
Test Pumping Rate:		Gallons Per Minute	Well yielded	GPM with a	drawdown of	
Duration of Pump To	est (minimum 4 hou	urs):hours	feet after	h	ours of pumping	
Patrick M	. Chism	atements are true to the best 0 6 9 5 se No. (if applicable)	of my knowledge. Patrick M Signature of Pump	Chran		

RECEIVED OCT 1 1 2004 BY: OLWR