

County: Bolivar
 Permit #: _____
 Driller: Charles M. Nichols
 Date drilling completed: 5-22-08

State Well Report
Part 1 - Driller's Log

Mississippi Department of Environmental Quality
 Office of Land and Water Resources
 P.O. Box 10631
 Jackson, MS 39289-0631
 (601)961-5210
 (601)354-6938 (fax)

For Office Use Only:
 Aquifer: _____
 Well #: T-199
 L. S. Elevation: _____
 E-log #: _____

State Law requires that this report be prepared by the license holder responsible for the work and filed with the Department at the above address within 30 days of completion of drilling of the well or borehole.

Information on Well Owner <i>(Landowner if borehole is not for a water well)</i>	Well or Borehole Location
Owner Name: <u>R. D. Reed FARMS</u>	Latitude: <u>33° 32' 53.5" N</u> Longitude: <u>90° 51' 9.8" W</u>
Mailing Address: <u>102 PENINSULA DR.</u>	Method of Lat/Long (circle one): Conventional Survey, <u>36</u>
<u>Leland</u> <u>MS</u> <u>38751</u>	USGS quad, <u>Hand-held GPS</u> , Survey-grade GPS
City State Zip Code	<u>Nw 1/4 Nw 1/4</u> Sec <u>31</u> Twn <u>20N</u> Rng <u>6W</u>
Telephone No. () _____	Distance Direction Nearest Town <u>3</u> Miles <u>west</u> of <u>Choctaw</u>

Well / Borehole Data

Date drilling started: 5-12-08 Date drilling completed: 5-15-08 Hole depth: 480 Hole diameter: 5 7/8 x 7/8

Location of the source of any surface water used for drilling: Shop well
 Method of dosing and volume of Chlorine used in drilling and development: _____

Logs run (circle all applicable): No log run Electric Gamma Ray Density Sonic Neutron Other: _____
 Name of organization running log(s): _____

Purpose of borehole (check one): Water Well Geotechnical/Geological Investigation _____ Ground Source Heat Pump _____
 Seismic Survey _____ Other (describe) _____
If drilling is not related to water well construction, skip the remainder of this block

Purpose of Well (check one): Home Industrial _____ Public Supply _____ Irrigation _____ Fish Culture _____ Other: _____

If a flowing well, method of flow regulation: Valve _____ Other (describe) _____

Static Water Level: 41 feet above or below (circle one) land surface Date measured: 5-22-08

Method of Measurement (circle one) steel tape electric tape air line other: _____

Well depth: 480 Well grouted to a depth of 20 feet Type of grout (circle one): Neat Cement Bentonite Mix

Casing length: 460 feet Casing diameter: 4x2 inches Type of casing: plu

Screen length: 20 feet Screen diameter: 2 inches Type of screen: plu

Screen slot size: .008 inches Setting depth: From 460 feet to 480 feet

Type of completion (circle all applicable): Gravel packed Underreamed Telescoped Open hole Natural Development
 Other (describe): _____

Top of lap pipe or reduction in casing: 150 feet. *If telescoped or more than one screen, describe on next page*


Form: OLWR-SWR-1A

RECEIVED
 JUL 23 2008
 BY: OLWR

The sketch below only required for water wells

Description of formations encountered must be provided for all wells and boreholes, unless specifically exempted by regulations


If well telescopes, show depths on sketch

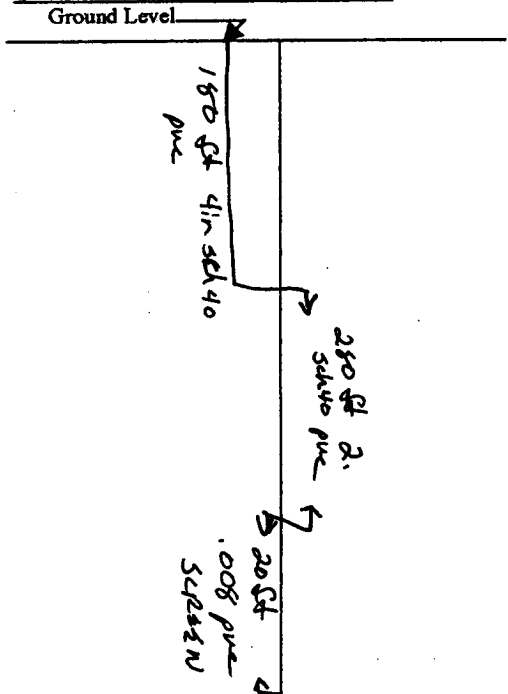

Description of Formations Encountered	From (depth)	To (depth)
Clay	Ground Level	15
sand - py. gravel + gravel	15	165
clay	165	340
clay w/ sand streaks	340	410
sand little clay	410	440
COURSE sand	440	480

If more than one screen, show location of each on sketch

Sketch the property layout and include the following: 1) the well location; 2) any permanent structures on the property that may aid in locating the well; 3) any roads, power lines, or other items that may aid in locating the property and the well; 4) a north arrow.

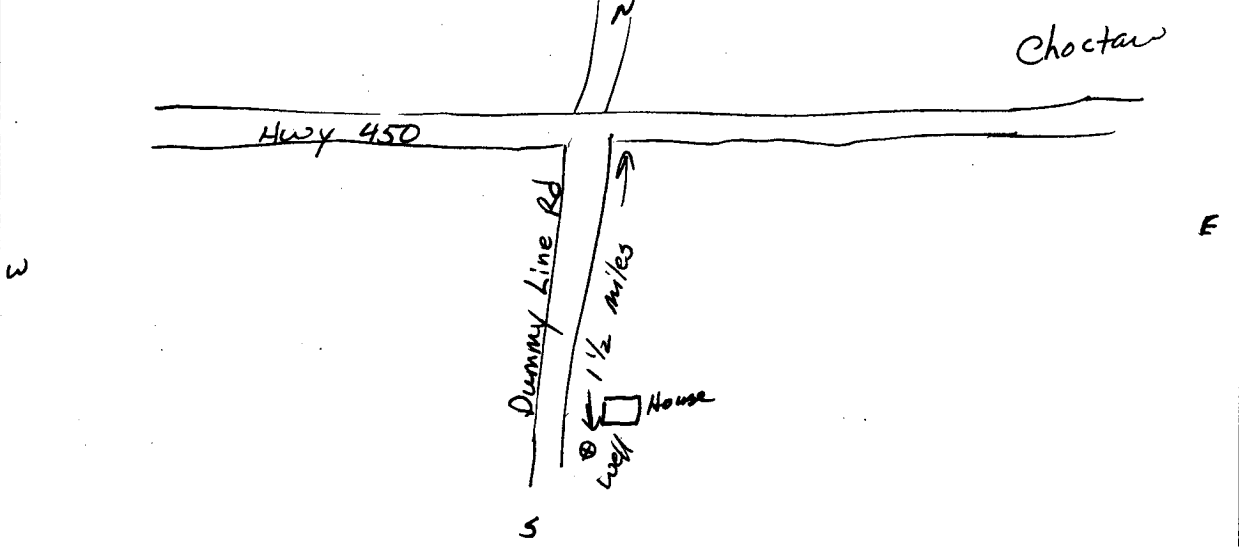

Landowner Name: Rodney Reed

Form: OLWR-SWR-1A

I certify that the well/borehole was drilled, constructed, and completed in accordance with all applicable requirements of the Mississippi Department of Environmental Quality and the Mississippi Department of Health regulations, if applicable, and state laws.

Print Name of Responsible Licensee and License No. Charles M. Nichols 0-0667 Date _____

Signature of Licensee *Charles M. Nichols*

RECEIVED

JUL 23 2008

BY: OLWR

STATE WELL REPORT

Part 2

Pump Installer's Completion Report
 Mississippi Department of Environmental Quality
 Office of Land and Water Resources
 P.O. Box 10631
 Jackson, MS 39289-0631
 (601)961-5210
 (601)354-6938 (fax)

County: Bolivar
 Permit #: _____
 Driller: Charles M. Nichols
 Date completed: 5-22-09
Copy information from block on Part 1

For Office Use Only:

Aquifer: _____
 Well #: T-199
 Elevation: _____

This part of the report must be completed by a licensed water well contractor or a licensed pump installer. A copy of Part 1 of the report must be attached and both parts filed with the Department at the above address within 30 days of well completion.

Well Owner Information	Well Location
Owner Name: <u>R.D. Reed FARMS</u>	Latitude: <u>33°32.585N</u> Longitude: <u>090°51.913W</u>
Mailing Address: <u>102 PENINSULAR</u>	Method of Lat/Long (check one): Conventional Survey _____
<u>Heland Ms 38756</u>	USGS quad _____, Hand-held GPS <input checked="" type="checkbox"/> , Survey-grade GPS _____
City State Zip Code	_____ 1/4 _____ 1/4 Sec _____ T _____ R _____
Telephone No. () _____	Distance Direction Nearest Town
	<u>3</u> Miles <u>west</u> of <u>Choctaw</u>

Pump Type Circle one	Power Type Circle one
Air Lift Jet <input type="radio"/> <input checked="" type="radio"/> <u>Submersible</u>	Diesel Engine Gasoline Engine Natural Gas
Bucket Piston Turbine	Electric Motor Hand Tractor PTO
Centrifugal Rotary Flowing Well	Windmill Other (specify): _____
Other (specify): <u>CUSTOMER pump.</u>	Horse Power Rating of Motor: <u>1</u>
Date Pump Installed: <u>5-22-09</u>	Setting Depth: <u>100</u> feet
Rated Pump Capacity: <u>8</u> Gallons Per Minute	Number of Stages: _____

Pump Test Data	Method of Measuring Water Level Circle one
Date Well Tested: <u>5-22-09</u>	Air Line Electric Measuring Line <input checked="" type="radio"/> <u>Steel Tape</u>
Static Water Level (A): <u>41</u> Feet Below Land Surface	Other (specify): _____
Pumping Water Level (B): _____ Feet Below Land Surface	For flowing well, measured shut in head: _____ feet
Drawdown [(B) - (A)]: _____ Feet Below Land Surface	Well yielded _____ GPM with a drawdown of _____
Test Pumping Rate: _____ Gallons Per Minute	_____ feet after _____ hours of pumping
Duration of Pump Test (minimum 4 hours): _____ hours	

I HEREBY CERTIFY that the above statements are true to the best of my knowledge.

Charles M. Nichols 0-0667 Charles M. Nichols
 Print Name of Pump Installer and License No. (if applicable) Signature of Pump Installer

Form: OLWR-SWR-1B

RECEIVED

JUL 23 2008

BY: OLWR