

County: Bolivar
 Permit #: GW43316
 Irrigation Equipment
 Driller:
 Date drilling completed: 6-26-09

State Well Report

Part 1

Mississippi Department of Environmental Quality
 Office of Land and Water Resources
 P.O. Box 10631
 Jackson, MS 39289-0631
 (601)961-5210
 (601)354-6938 (fax)

For Office Use Only:
 Aquifer:
 Well #: T 203
 L. S. Elevation:
 E-log #:

State Law requires that this report be prepared by the driller in detail and filed with the Department within 30 days of completion of drilling of the well.

Well Owner Information	Well Location
Owner Name: <u>Morgan Planting</u>	Latitude: <u>33° 35' 40"</u> Longitude: <u>90° 49' 40"</u>
Mailing Address: <u>2612 Hwy 448</u>	Method of Lat/Long (circle one): <u>Conventional Survey</u>
<u>Shaw</u> <u>Ms.</u> <u>38773</u>	USGS quad, <u>Hand-held GPS</u> , <u>Survey-grade GPS</u>
City State Zip Code	<u>NE</u> 1/4 <u>NW</u> 1/4 Sec <u>9</u> Twn <u>20N</u> Rng <u>6W</u>
Telephone No. ()	SE Distance <u>3</u> Miles Direction <u>W</u> of Nearest Town <u>Shaw</u>

Well Data Pivot

Purpose of Well (circle one) Home Industrial Public Supply Irrigation Fish Culture Other Replacement

Date well drilling started: 6-26-09 Date well drilling completed: 6-26-09

If flowing, method of flow regulation: Valve _____ Other (describe) _____

Static Water Level: 34 feet above of below (circle one) land surface Date measured: 6-27-09

Method of Measurement (circle one) steel tape electric tape air line other: _____

Hole depth: 134 Well depth: 134 Well grouted to a depth of 10 feet

Type of grout (circle one): Cement Bentonite Mix

Casing length: 94 feet Casing diameter: 16 inches Type of casing: PVC

Screen length: 40 feet Screen diameter: 16 inches Type of screen: PVC

Screen slot size: .050 inches Setting depth: From 95 feet to 134 feet

Type of completion (circle all applicable): Gravel packed Underreamed Telescoped Open hole Natural Development

Other (describe): _____

Top of lap pipe or reduction in casing: _____ feet. If telescoped or more than one screen, describe on back of page


Logs run (circle all applicable) No log run Electric Gamma Ray Density Sonic Neutron Other: _____

Name of organization running log(s): _____

I certify that the well was drilled, constructed, and completed in accordance with all applicable requirements of the Mississippi Department of Environmental Quality and/or the Mississippi Department of Health regulations and state laws.


Irrigation Equipment Inc.
 John P. Chism 0439

Print Name of Water Well Contractor and License No. _____

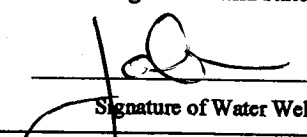Signature of Water Well Contractor 

Replaces GW10718

 RECEIVED
 JUL 07 2009
 BY: OLWR



If well telescopes please sketch below and show depths.


Ground Level

Description of Formations Encountered	From	To
Clay	0	17
Brown Sand	18	27
Medium Sand	28	67
Course Sand + Pea Gravel	68	134


If more than one screen, show location of each on sketch

Sketch the property layout and include the following: 1) the well location; 2) any permanent structures on the property that may aid in locating the well; 3) any roads, power lines, or other items that may aid in locating the property and the well; 4) indicate direction.

Landowner Name: Morgan Planting

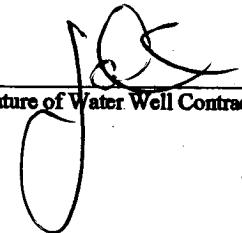
 Signature of Water Well Contractor

RECEIVED
 JUL 07 2009
 BY: OLWR

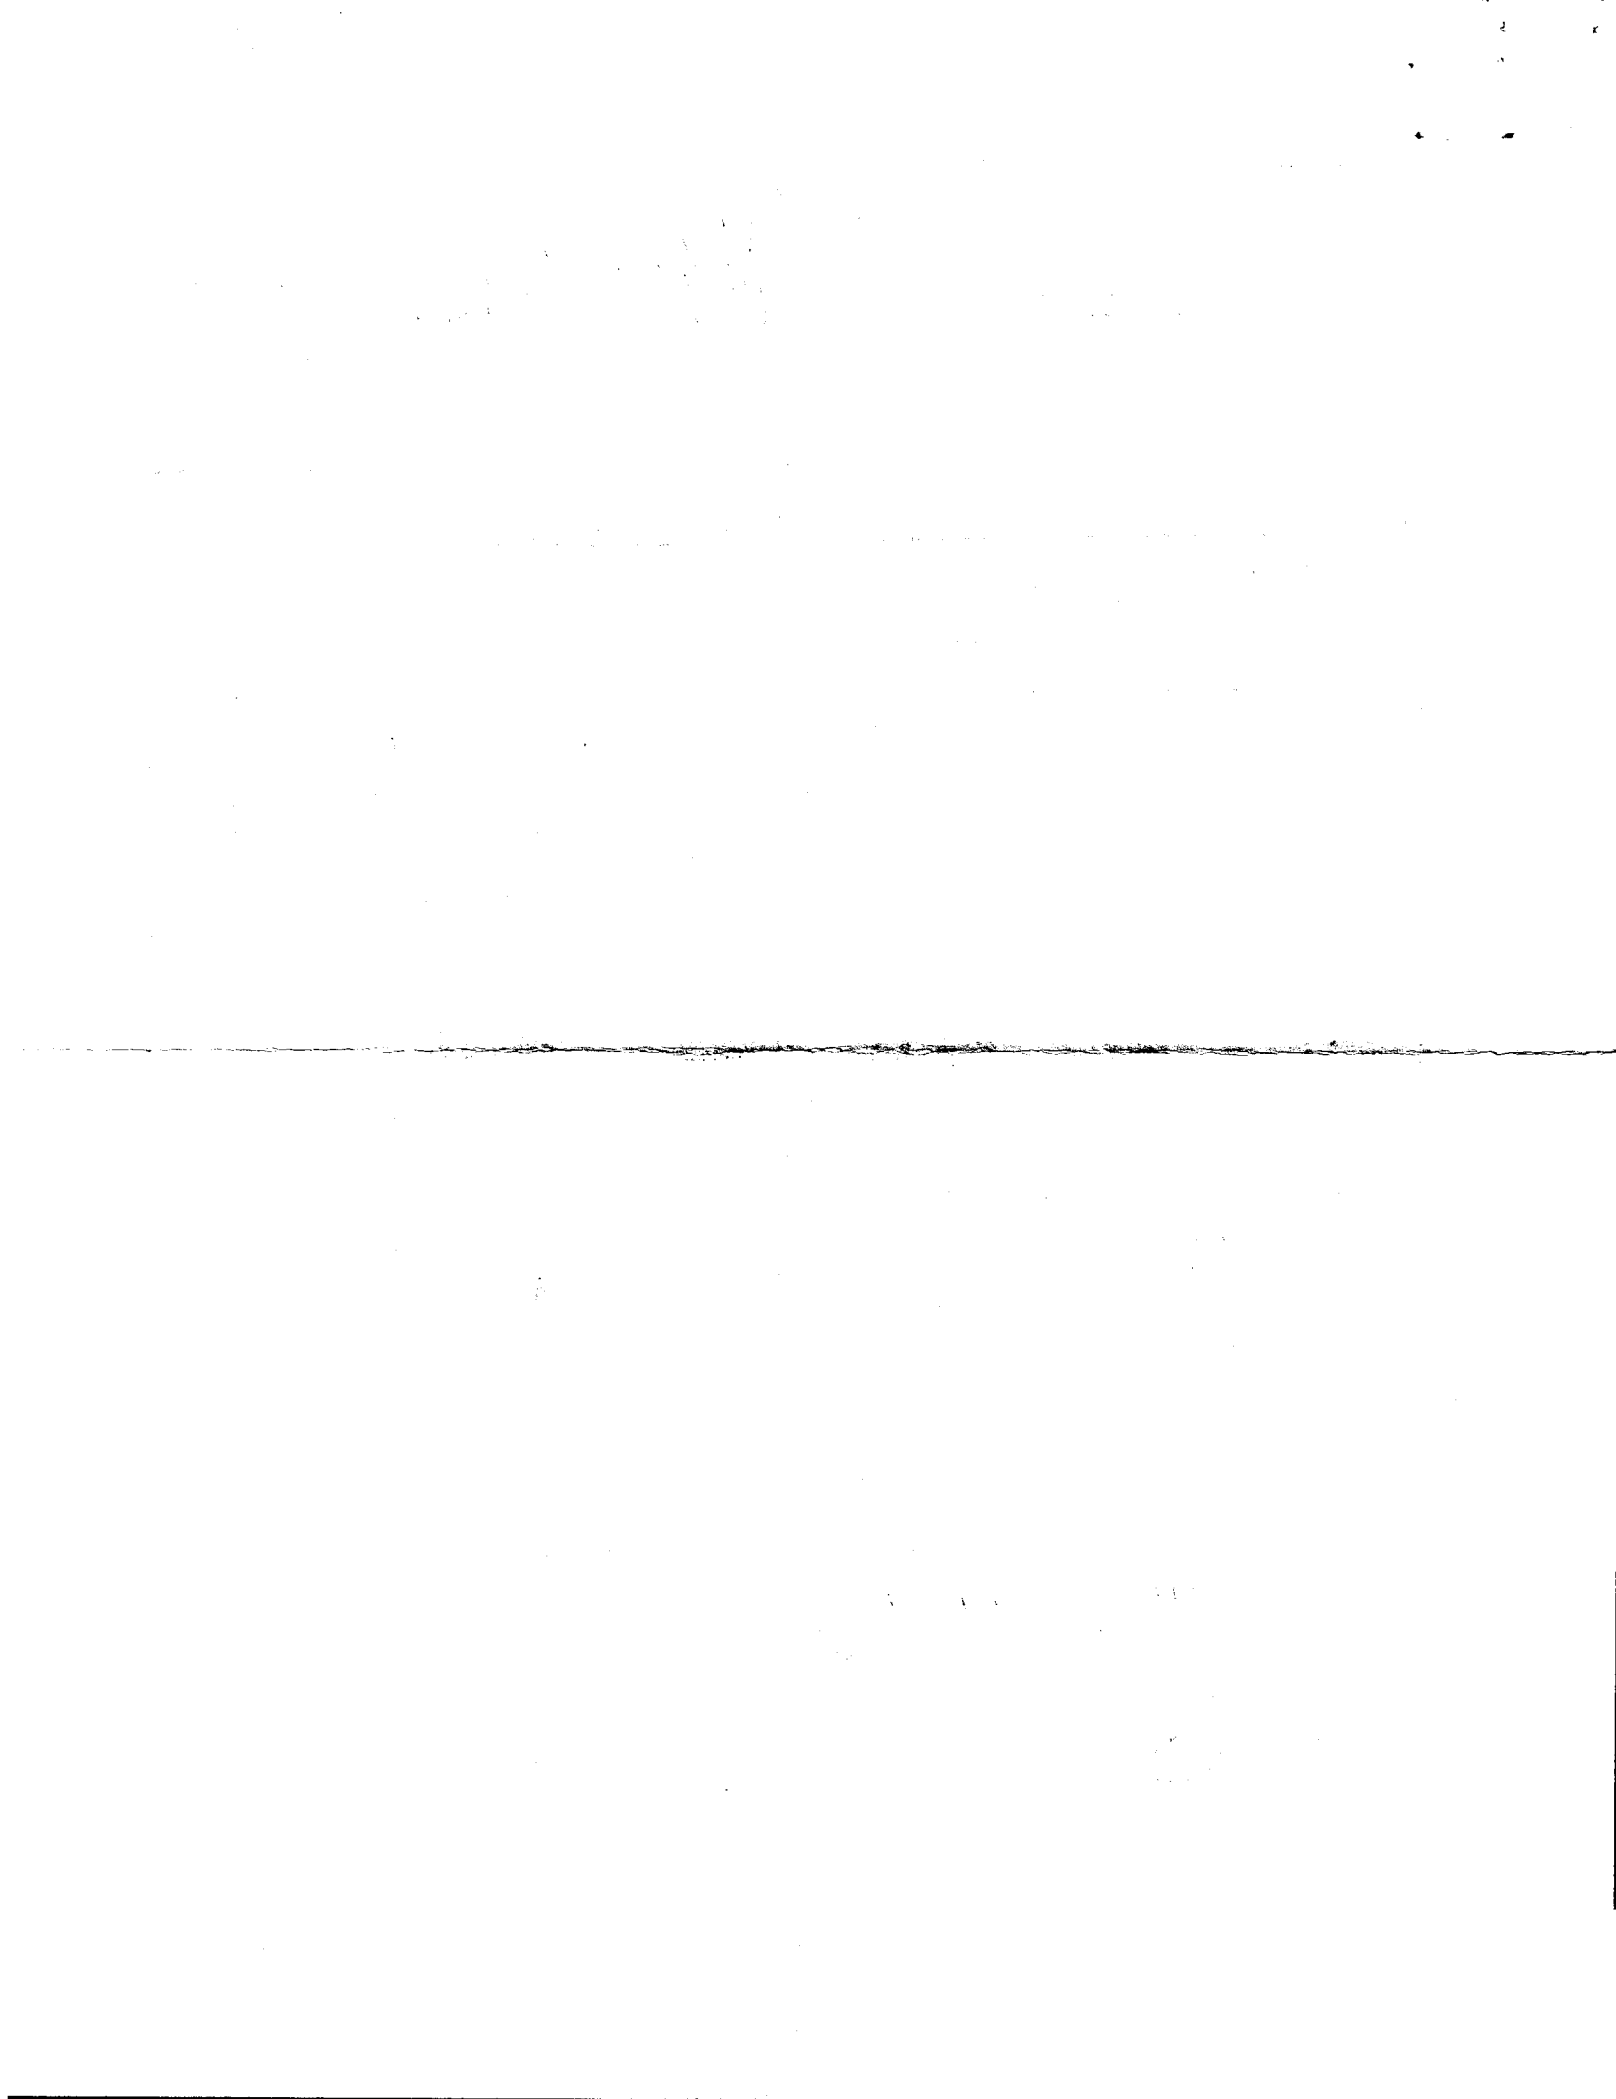

STATE WELL REPORT

Part 2

Pump Installer's Completion Report
Mississippi Department of Environmental Quality
Office of Land and Water Resources
P.O. Box 10631
Jackson, MS 39289-0631
(601)961-5210
(601)354-6938 (fax)

County: Bolivar
 Permit #: _____
 Irrigation Equipment
 Driller: _____
 Date completed: 6-26-09

For Office Use Only:

Aquifer: _____
 Well #: T 203
 Elevation: _____

This report should be prepared by the pump installer in detail and filed with the Department within 30 days of the installation of pump.

Well Owner Information	Well Location
Owner Name: <u>Morgan Planting</u>	Latitude: <u>33° 35' 56"</u> Longitude: <u>90° 49' 38"</u>
Mailing Address: <u>2612 Hwy 448</u>	Method of Lat/Long (circle one): Conventional Survey, USGS quad, Hand-held GPS, Survey-grade GPS
<u>Shaw</u> <u>Ms.</u> <u>38773</u> City State Zip Code	<u>NE</u> ¼ <u>NW</u> ¼ Sec <u>9</u> Twn <u>20N</u> Rng <u>6W</u>
Telephone No. () _____	Distance Direction Nearest Town <u>3</u> Miles <u>W</u> of <u>Shaw</u>

Pump Type Circle one	Power Type Circle one
Air Lift Jet Submersible	<u>Diesel Engine</u> Gasoline Engine Natural Gas
Bucket Piston <u>Turbine</u>	Electric Motor Hand Tractor PTO
Centrifugal Rotary Flowing Well	Windmill Other (specify): _____
Other (specify): _____	Horse Power Rating of Motor: <u>150</u>
Date Pump Installed: <u>6-27-09</u>	Setting Depth: <u>70</u> feet
Rated Pump Capacity: _____ Gallons Per Minute	Number of Stages: <u>3</u>


Pump Test Data	Method of Measuring Water Level Circle one
Date Well Tested: _____	Air Line Electric Measuring Line Steel Tape
Static Water Level (A): _____ Feet Below Land Surface	Other (specify): _____
Pumping Water Level (B): _____ Feet Below Land Surface	For flowing well, measured shut in head: _____ feet
Drawdown [(B) - (A)]: _____ Feet Below Land Surface	Well yielded _____ GPM with a drawdown of _____ feet after _____ hours of pumping
Test Pumping Rate: _____ Gallons Per Minute	
Duration of Pump Test (minimum 4 hours): _____ hours	

I HEREBY CERTIFY that the above statements are true to the best of my knowledge.

John P. Chism 0439
 Print Name of Pump Installer and License No. (if applicable)

 Signature of Pump Installer

RECEIVED
 JUL 07 2009
 BY: OLWR

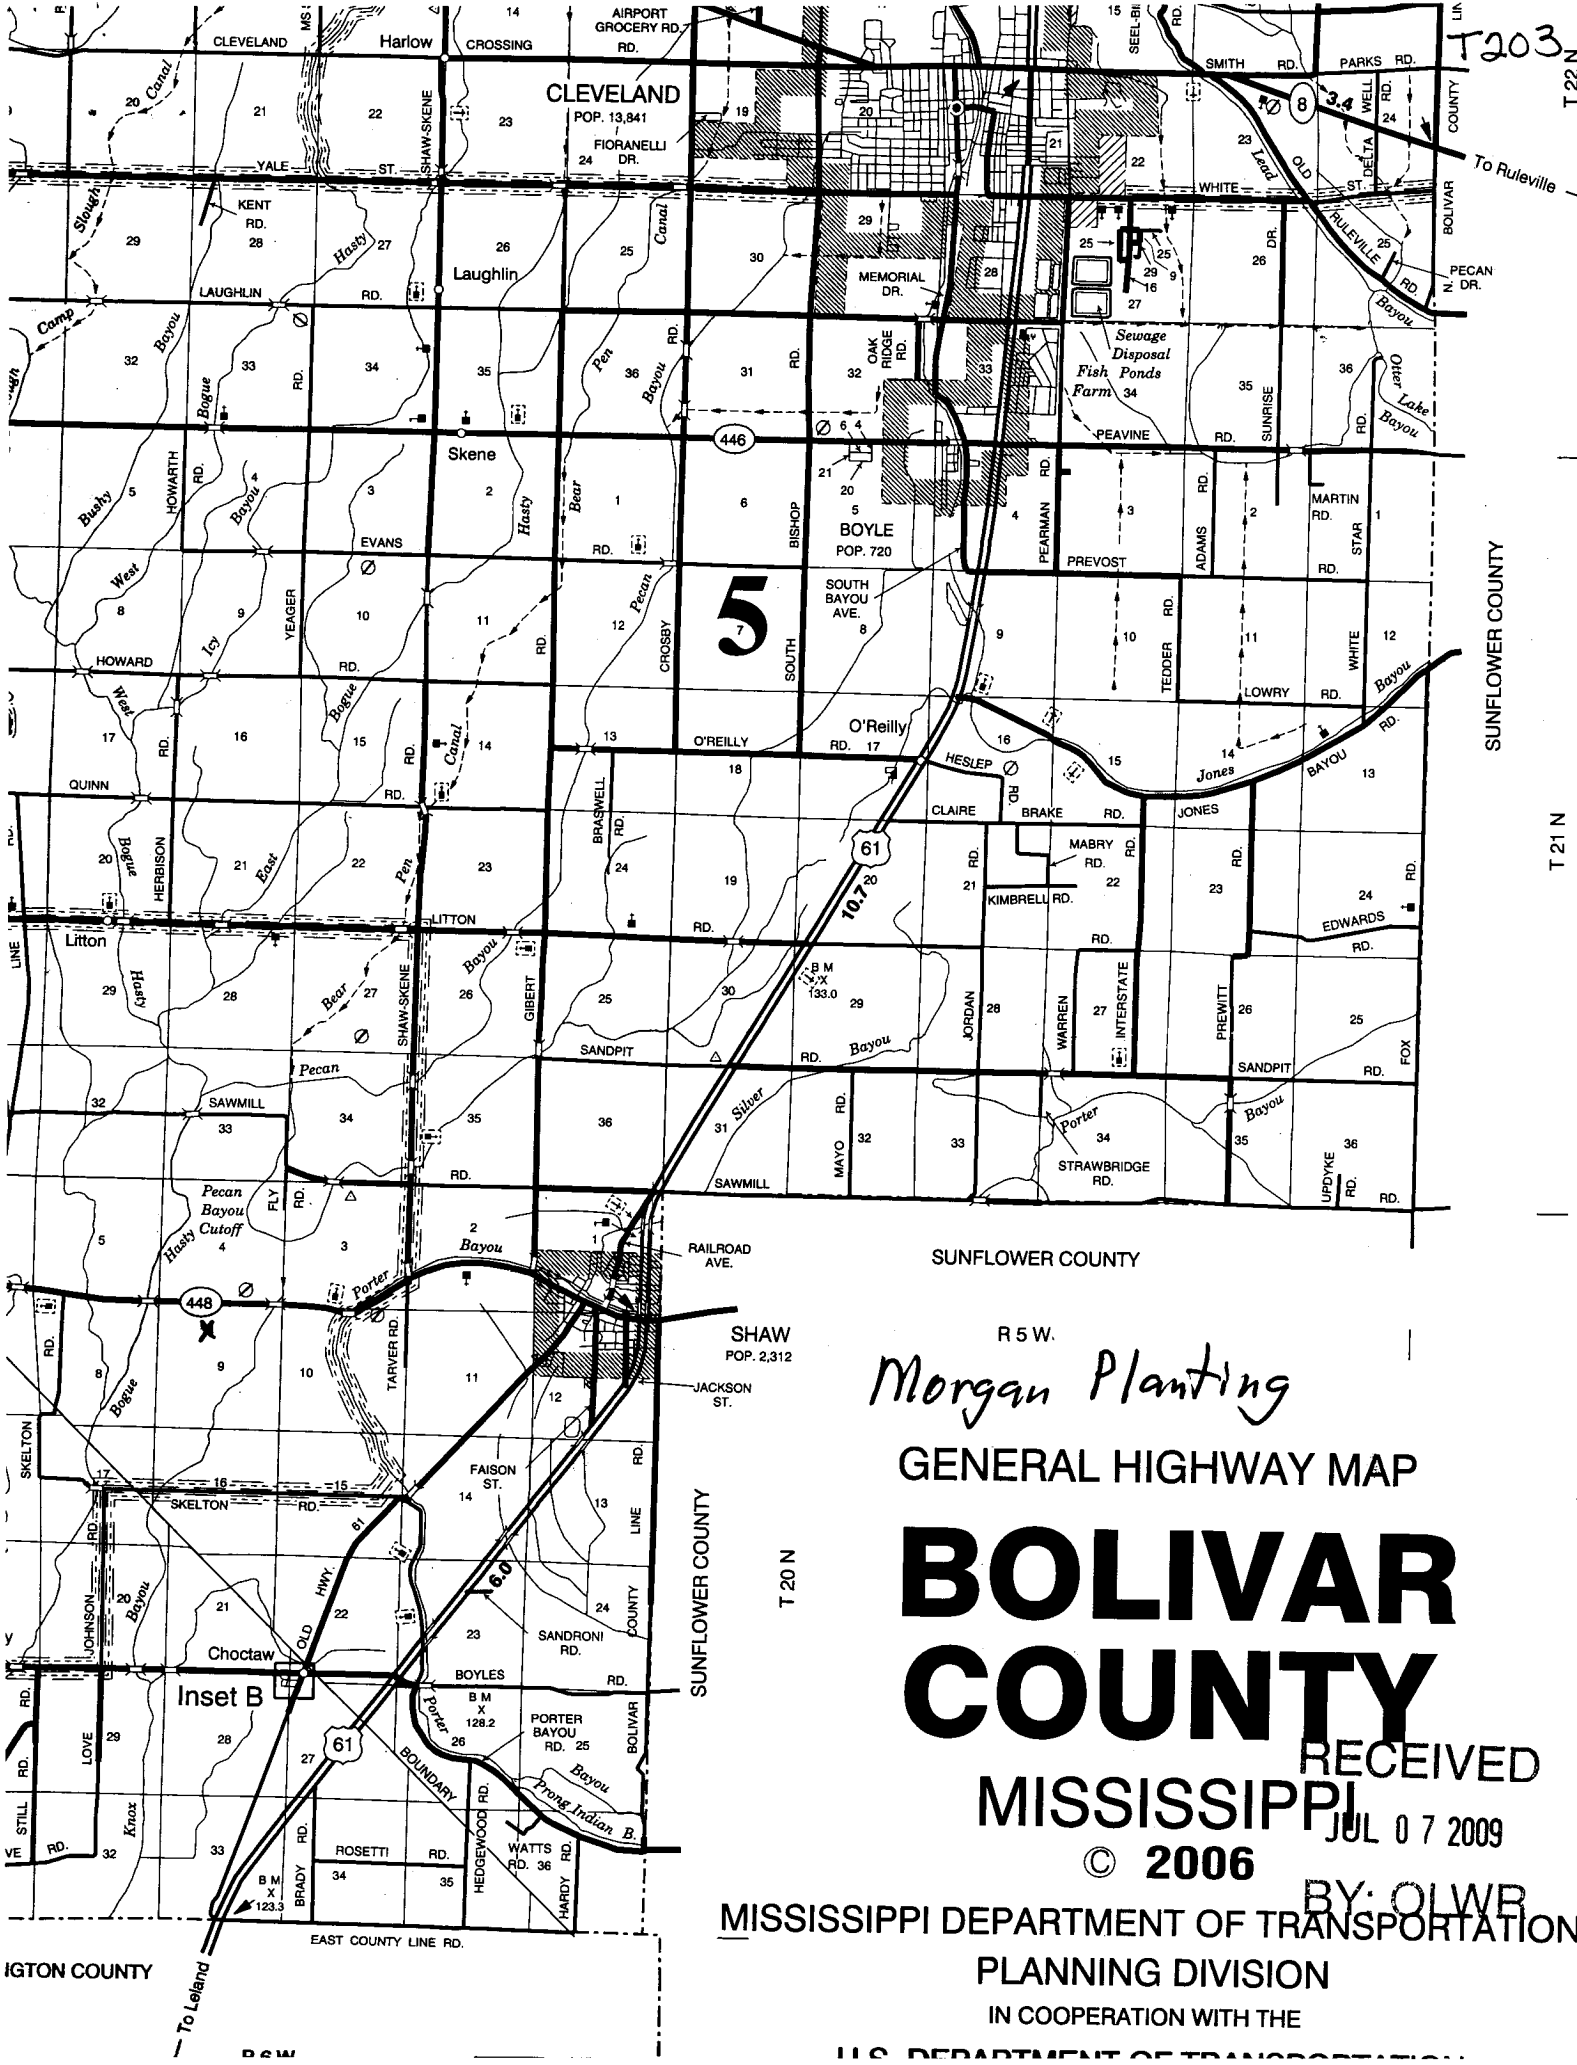

T203
T 22 N

SUNFLOWER COUNTY

T 21 N

SUNFLOWER COUNTY

R 5 W.

Morgan Planting

GENERAL HIGHWAY MAP

BOLIVAR COUNTY

RECEIVED
MISSISSIPPI
JUL 07 2009

© 2006

BY: OLWB

MISSISSIPPI DEPARTMENT OF TRANSPORTATION
PLANNING DIVISION
IN COOPERATION WITH THE
U.S. DEPARTMENT OF TRANSPORTATION

IGTON COUNTY

BSW