

County: Bolivar
 Permit #: GW-44168
 Irrigation Equipment
 Driller: _____
 Date drilling completed: 4-20-10

State Well Report

Part 1 - Driller's Log

Mississippi Department of Environmental Quality
 Office of Land and Water Resources
 P.O. Box 2309
 Jackson, MS 39225
 (601)961- 5210
 (601)961- 5228 (fax)

For Office Use Only:
 Aquifer: T 208
 Well #: _____
 L. S. Elevation: _____
 E-log #: _____

State Law requires that this report be prepared by the license holder responsible for the work and filed with the Department at the above address within 30 days of completion of drilling of the well or borehole.

Information on Well Owner (Landowner if borehole is not for a water well)	Well or Borehole Location
Owner Name <u>Duke Morgan Sr.</u>	Latitude: <u>33° 35' 40.0</u> Longitude: <u>90° 49' 41.2</u>
Mailing Address: <u>2612 Hwy 448</u>	Method of Lat/Long (circle one): Conventional Survey, USGS quad <u>(Hand-held GPS)</u> Survey-grade GPS
<u>Shaw</u> <u>Ms.</u> <u>38773</u> City State Zip Code	<u>SE</u> ¼ <u>NW</u> ¼ Sec <u>9</u> Twn <u>20N</u> Rng <u>6W</u>
Telephone No. <u>(662) 719-3389</u>	Distance Direction Nearest Town <u>3</u> Miles <u>W</u> of <u>Shaw</u>

Well / Borehole Data

Date drilling started: 4-20-10 Date drilling completed: 4-20-10 Hole depth: 135 Hole diameter: 24"

Location of the source of any surface water used for drilling: Surface Water
 Method of dosing and volume of Chlorine used in drilling and development: 50 PPM

Logs run (circle all applicable): (No log run) Electric Gamma Ray Density Sonic Neutron Other: _____
 Name of organization running log(s): _____

Purpose of borehole (check one): Water Well Geotechnical/Geological Investigation _____ Ground Source Heat Pump _____
 Seismic Survey _____ Other (describe) _____

If drilling is not related to water well construction, skip the remainder of this block

Purpose of Well (check one): Home _____ Industrial _____ Public Supply _____ Irrigation Pivot Fish Culture _____ (Other) Replacement

If a flowing well, method of flow regulation: Valve _____ Other (describe) _____

Static Water Level: 32 feet above or (below) (circle one) land surface Date measured: 4-21-10

Method of Measurement (circle one) (steel tape) electric tape air line other: _____

Well depth: 135 Well grouted to a depth of 10 feet Type of grout (circle one): Neat Cement (Bentonite) Mix

Casing length: 95 feet Casing diameter: 16 inches Type of casing: PVC

Screen length: 40 feet Screen diameter: 16 inches Type of screen: PVC

Screen slot size: .050 inches Setting depth: From See back feet to _____ feet

Type of completion (circle all applicable): (Gravel packed) Underreamed Telescoped Open hole Natural Development
 Other (describe): _____

Top of lap pipe or reduction in casing: _____ feet. *If telescoped or more than one screen, describe on next page*

Form: OLWR-SWR-1A (04/08)


RECEIVED
 MAY 05 2010
 BY: OLWR

T 208

The sketch below only required for water wells

If well telescopes, show depths on sketch.

Ground Level →

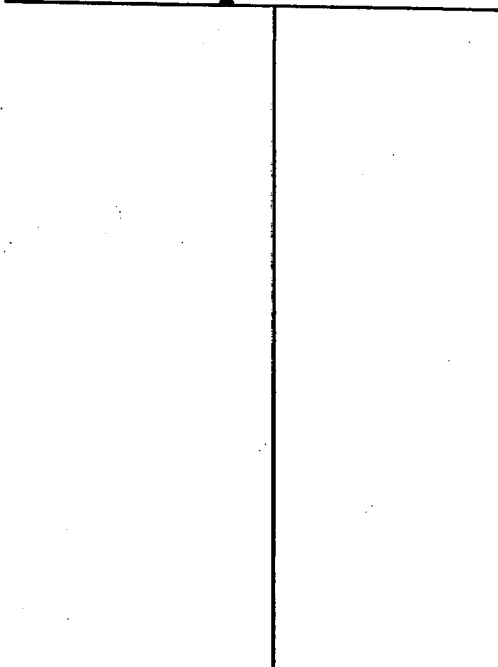

Description of formations encountered must be provided for all wells and boreholes, unless specifically exempted by regulations

Description of Formations Encountered	From (depth)	To (depth)
Clay	Ground Level	23
Fine Sand	24	39
Fine Sand + Gravel	40	53
Medium Sand + Gravel	54	96
Fine Sand + Gravel	97	112
Medium Sand + Gravel	113	135
Screen: .050		
(76 - 95) 20'		
(96 - 115) 20' Blanked		
(116 - 135) 20'		

If more than one screen, show location of each on sketch

Sketch the property layout and include the following: 1) the well location; 2) any permanent structures on the property that may aid in locating the well; 3) any roads, power lines, or other items that may aid in locating the property and the well; 4) a north arrow.

Landowner Name: Duke Morgan Sr.

Form: OLWR-SWR-1A (04/08)

I certify that the well/borehole was drilled, constructed, and completed in accordance with all applicable requirements of the Mississippi Department of Environmental Quality and the Mississippi Department of Health regulations, if applicable, and state laws.

Patrick M. Chism 0695 _____
Print Name of Responsible Licensee and License No. Date Signature of Licensee

RECEIVED
MAY 05 2010
BY: OLWR

County: Bolivar
 Permit #: GW-44168
 Irrigation Equipment
 Driller: _____
 Date completed: 4-20-10
Copy information from block on Part 1

STATE WELL REPORT

Part 2

Pump Installer's Completion Report
 Mississippi Department of Environmental Quality
 Office of Land and Water Resources
 P.O. Box 2309
 Jackson, MS 39225
 (601)961-5210
 (601)961-5228 (fax)

For Office Use Only:
 Aquifer: T208
 Well #: _____
 Elevation: _____

This part of the report must be completed by a licensed water well contractor or a licensed pump installer. A copy of Part 1 of the report must be attached and both parts filed with the Department at the above address within 30 days of well completion.

Well Owner Information	Well Location
Owner Name: <u>Duke Morgan Sr.</u>	Latitude: _____ Longitude: _____
Mailing Address: <u>2612 Hwy 448</u>	Method of Lat/Long (check one): Conventional Survey _____
<u>Shaw Ms. 38773</u>	USGS quad _____, Hand-held GPS <input checked="" type="checkbox"/> , Survey-grade GPS _____
City State Zip Code	<u>SE 1/4 NW 1/4 Sec 9 T 20N R 6W</u>
Telephone No. <u>662 719-3389</u>	Distance _____ Direction _____ Nearest Town _____
	<u>3</u> Miles <u>W</u> of <u>Shaw</u>

Pump Type	Power Type
Circle one	Circle one
Air Lift <input type="checkbox"/> Jet <input type="checkbox"/> Submersible <input type="checkbox"/>	<u>Diesel Engine</u> Gasoline Engine Natural Gas
Bucket <input type="checkbox"/> Piston <input type="checkbox"/> <u>Turbine</u>	Electric Motor Hand Tractor PTO
Centrifugal <input type="checkbox"/> Rotary <input type="checkbox"/> Flowing Well <input type="checkbox"/>	Windmill Other (specify): _____
Other (specify): _____	Horse Power Rating of Motor: <u>150</u>
Date Pump Installed: <u>4-21-10</u>	Setting Depth: <u>70</u> feet
Rated Pump Capacity: _____ Gallons Per Minute	Number of Stages: <u>3</u>


Pump Test Data	Method of Measuring Water Level
Circle one	Circle one
Date Well Tested: _____	Air Line <input type="checkbox"/> Electric Measuring Line <input type="checkbox"/> Steel Tape <input type="checkbox"/>
Static Water Level (A): _____ Feet Below Land Surface	Other (specify): _____
Pumping Water Level (B): _____ Feet Below Land Surface	For flowing well, measured shut in head: _____ feet
Drawdown [(B) - (A)]: _____ Feet Below Land Surface	Well yielded _____ GPM with a drawdown of _____ feet after _____ hours of pumping
Test Pumping Rate: _____ Gallons Per Minute	
Duration of Pump Test (minimum 4 hours): _____ hours	

This is for (circle one): New Well Replacement of Existing Pump Repair of Existing Pump

I HEREBY CERTIFY that the above statements are true to the best of my knowledge.
Patrick M. Chism 0695
 Print Name of Pump Installer and License No. (if applicable) Patrick M. Chism
 Signature of Pump Installer

Form: OLWR-SWR-10 (07-09)
 RECEIVED
 MAY 05 2010
 BY: OLWF

T 208

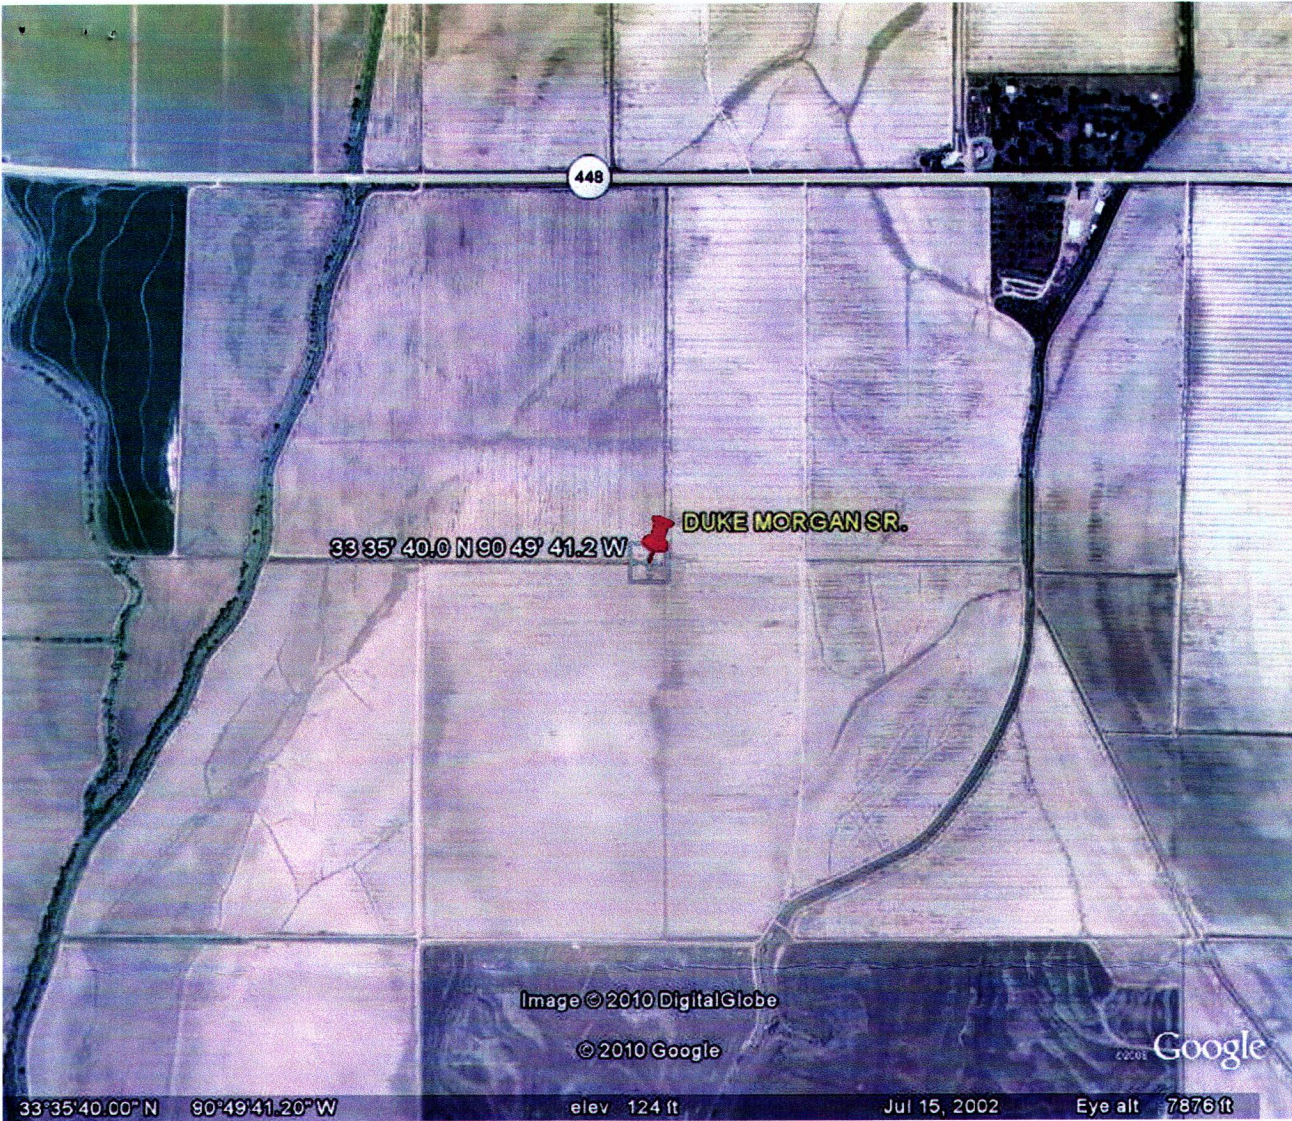

RECEIVED
MAY 05 2010
BY: OLWR