

STATE WELL REPORT

Part I

Driller's Log

Mississippi Department of Environmental Quality
 Office of Land and Water Resources
 P.O. Box 2309
 Jackson, MS 39225-2309
 (601)961-5210
 (601)360-0535 (fax)

For Office Use Only:

Well #: T 222
 Aquifer: _____
 E-Log #: _____

County Bolivar
 Permit #: GW-47273
 Driller: Clearance McMurry
 Date drilling completed: 5-8-13

State Law requires that this report be prepared by the license holder responsible for the work and filed with the Department at the above address within 30 days of completion of drilling of the well or borehole.

#1763 Well Owner Information (Landowner if borehole is not for a water well)			Well or Borehole Location		
Owner Name: <u>KNB Farms</u>			Latitude: <u>33° 36' 27"</u> Longitude: <u>90° 42' 53"</u>		
Mailing Address: <u>127 Aunsley Cove</u>			Method of Lat/Long (check one): Conventional Survey _____ USGS quad _____, Hand-held GPS <input checked="" type="checkbox"/> , Survey-grade GPS _____		
<u>Cleveland</u> City	<u>MS</u> State	<u>38732</u> Zip Code	<u>NW 1/4 SW 1/4, Sec 02 T 20N R 06W</u>		
Telephone No. <u>(662) 822-7359</u>			<u>1.4</u> Miles <u>W</u> of <u>Shaw</u> (Distance) (Direction) (Nearest Town)		

Well / Borehole Data

Date drilling started: 5-8-13 Date drilling completed: 5-8-13 Hole depth: 125' Hole diameter: 22"

Location of the source of any surface water used for drilling: Hauled water

Method of dosing and volume of Chlorine used in drilling and development: _____

Logs run (circle all applicable): No log run Electric Gamma Ray Density Sonic Neutron Other: _____

Name of organization running log(s): _____

Purpose of borehole (circle one): Water Well Geotechnical/Geological Investigation Ground Source Heat Pump
 Seismic Survey Other (describe) _____

If drilling is not related to water well construction, skip the remainder of this block

Purpose of Well (circle all applicable): Home Industrial Public Supply Irrigation Fish Culture

Other (describe): _____

If a flowing well, method of flow regulation: Valve _____ Other (describe) N/A

Static Water Level: 42 feet (above or below land surface (circle one)) Date measured: 5-9-13

Method of measurement (circle one): Steel tape Electric tape Air line Other (describe): _____

Well depth: 125' Well grouted to a depth of 10 feet Type of grout (circle one): Heat Cement Bentonite Mix

Casing length: 85 feet Casing diameter: 12 inches Type of casing: PVC

Screen length: 40 feet Screen diameter: 12 inches Type of screen: PVC

Screen slot size: 050 inches Setting depth: From 85 feet to 125 feet

Type of completion (circle all applicable): Gravel packed Underreamed Open hole Natural Development

Other (describe): _____

Top of lap pipe or reduction in casing: N/A feet

If telescoped or more than one screen, describe on next page

RECEIVED

MAY 13 2013

Form: OLWR-SWR-1A (4/13)

BY: OLWR

County: Bolivar
 Permit #: GW-47273

For Office Use Only:
 Well #: T222

The sketch below only required for water wells
If well telescopes, show depths on sketch.


Description of formations encountered must be provided for all wells and boreholes, unless specifically exempted by regulations

Ground Level

Description of Formations Encountered	From (depth)	To (depth)
CLAY	Ground level	15
Clay & Fine Sand	15	41
Medium Sand	41	45
Pea Gravel	45	66
GRAVEL	66	96
Pea Gravel & Coarse Sand	96	125

If more than one screen, show location of each on sketch

Sketch the property layout and include the following:
 1) the well location
 2) any permanent structures on the property that may aid in locating the well
 3) any roads, power lines, or other items that may aid in locating the property and the well
 4) north arrow

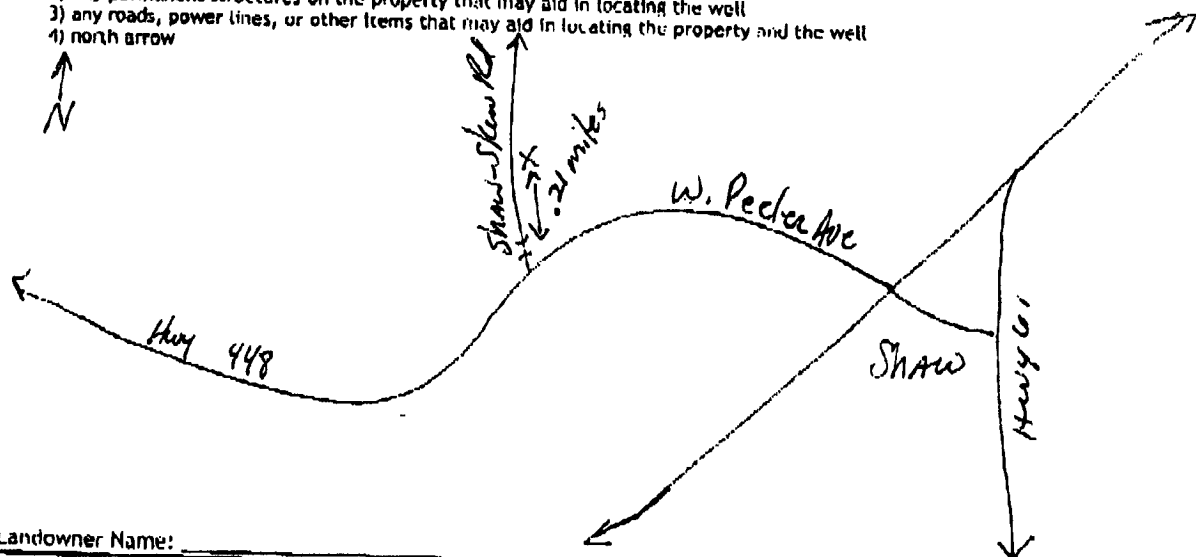

Landowner Name: _____

I HEREBY CERTIFY that the well/borehole was drilled, constructed, and completed in accordance with all applicable requirements of the Mississippi Department of Environmental Quality and the Mississippi Department of Health regulations, if applicable, and state laws.

Clayton Miller 0703 5-11-13 Clayton Miller
 Print Name of Responsible Licensee and License No. Date Signature of Licensee

RECEIVED
 MAY 13 2013
 BY [signature] MWR
 Form: OLWR SWR-1A (4/13)

STATE WELL REPORT

Part 2

Pump Installer's Completion Report
 Mississippi Department of Environmental Quality
 Office of Land and Water Resources
 P. O. Box 2309
 Jackson, MS 39225-2309
 (601)961-5210
 (601) 360-0535 (fax)

For Office Use Only:

Well # T.222

Aquifer: _____

County: Bilivar
 Permit #: GW-47273
 Driller: John Rybolt IV
 Date completed: 5-9-13
 Copy information from block on Part 1

This part of the report must be completed by a licensed water well contractor or a licensed pump installer. A copy of Part 1 of the report must be attached and both parts filed with the Department at the above address within 30 days of well completion.

Well Owner Information			Well Location	
Owner Name:	<u>KNB Farms</u>		Latitude:	<u>33° 36' 27"</u> Longitude: <u>90° 47' 53"</u>
Mailing Address:	<u>127 Annisley Cove</u>		Method of Lat/Long (check one):	Conventional Survey _____
			USGS quad _____	Hand-held GPS <input checked="" type="checkbox"/> Survey-grade GPS _____
<u>Cleveland</u>	<u>MS</u>	<u>38732</u>	<u>NW</u> 1/4 <u>SW</u> 1/4, Sec <u>02</u> <u>T200N</u> <u>R06W</u>	
City	State	Zip Code	<u>1.4</u> Miles <u>W</u> of <u>Shaw</u>	
Telephone No. (<u>662</u>) <u>822-7359</u>			(Distance) (Direction) (Nearest Town)	

Pump Type (circle one)

Submersible Turbine Air Lift Centrifugal Flowing Well Jet Piston Rotary Other (describe): _____

Date Pump Installed: 5-9-13 Rated Pump Capacity: _____ Gallons Per Minute

Is This Pump (circle one): New Repaired Replacement

Power Type (circle one)

Electric Diesel Gasoline Natural Gas Tractor PTO Windmill Other (describe): _____

Horse Power Rating of Motor: 25 Setting Depth: 80 feet Number of Stages: 1

Pump Test Data for Non Flowing Well

Date Well Tested: NOT TESTED Duration of Pump Test (minimum 4 hours): N/A hours

Static Water Level (A): _____ Feet Below Land Surface Pumping Water Level (B): N/A Feet Below Land Surface

Drawdown ((B) - (A)): N/A Feet Below Land Surface Test Pumping Rate: N/A Gallons Per Minute

Method of measurement (circle one): Steel tape Electric tape Air line Other (describe): N/A

Pump Test Data for Flowing Well

Measured shut in head: _____ feet.

Well yielded _____ GPM with a drawdown of _____ feet after _____ hours of pumping

Meter Installation

Meter Manufacturer: _____ Meter Serial Number: _____

Meter Model Number/Name: _____ Type of Meter: _____

Totalizer Register Unit and Multiplier Factor (AF x .001, gal x 1000, etc): _____

Installation Date: _____ Meter installed by: _____

Is This Meter (circle one): New Repaired Replacement

Important: By submitting the above information you are certifying that this meter was installed to manufacturer standards. For agricultural wells, a list of approved meters is on the MDEQ website.

I HEREBY CERTIFY that the above statements are true to the best of my knowledge.

Clayton Miller 0-703 5-11-13 Clayton Miller
 Print Name of Pump Installer and License No. (if applicable) Date Signature of Pump Installer

Form: OLWR-SWR-1B (4/13) MAY 13 2013

BY: OLWR