County: Bolivar Permit #: GW-50403 Driller: Irrigation Equipment, Inc. Date drilling completed: 6-2-18

STATE WELL REPORT

Part 1

Driller's Log
Mississippi Department of Environmental Quality
Office of Land and Water Resources P.O. Box 2309
Jackson, MS 39225-2309
(601) 961-5210
(601) 360-0535 (fax)

	Office Use Only:
Well #:	丁253
Aquifer:	
E-Log #:	

State Law requires that this report be prepared by the lice Department at the above address within 30 days of comp	
Well Owner Information (Landowner if borehole is not for a water well)	Well or Borehole Location
Owner Name: Giachelli Farms	Latitude: 33° 33' 58.1"N Longitude: 90° 50' 38.5"W
Mailing Address: 44 Majori Rd	Method of Lat/Long (check one): Conventional Survey,
	☐ USGS quad, ☑ Hand-held GPS, ☐ Survey-grade GPS
IndianolaMS38751CityStateZip code	<u>SE</u> ¼ <u>NW</u> ¼, Sec <u>20</u> T <u>20N</u> R <u>6W</u>
Telephone No. () -	Miles West of Choctaw
	(Distance) (Direction) (Nearest Town)
Well / Bor	ehole Data
Date drilling started: 6-2-18 Date drilling completed:	6-2-18 Hole depth: 125' Hole diameter: 24"
Location of the source of any surface water used for drilling:	urface Water
Method of dosing and volume of Chlorine used in drilling and deve	elopment: 50 PPM
Logs run (check all applicable): ☑ No log run ☐ Electric ☐ Gami	ma Ray 🗌 Density 🗌 Sonic 🗎 Neutron 🗎 Other:
Name of organization running log(s):	
Purpose of borehole (check one): "⊠ Water Well ☐ Geotech	nical/Geological Investigation
☐ Seismic Survey ☐ C	Other (describe)
If drilling is not related to water well con	struction, skip the remainder of this block
Purpose of Well (check all applicable): ☐ Home ☐ Industrial ☐ P	Other (describe) Struction, skip the remainder of this block ublic Supply ⊠ Irrigation □ Fish Culture
Other (describe):	\sim \sim \sim \sim \sim \sim \sim \sim \sim
If a flowing well, method of flow regulation: Valve	Other (describe)
Static Water Level: 35 feet [☐ above or ☒ below (check one)	w] land surface Date measured: 6-4-18
Method of Measurement (check one) $\ \ \ \ \ \ \ \ \ \ \ \ \ $	e 🗌 Air line 🗌 Other: (describe)
Well depth: 125 Well grouted to a depth of: 10 feet	Type of grout <i>(check one)</i> : ☐ Neat Cement ⊠ Bentonite ☐ Mix
Casing length: 85 feet Casing diameter: 16	inches Type of casing: PVC
Screen length: 40 feet Screen diameter: 16	inches Type of screen: PVC
Screen slot size: .050 inches Setting depth:	From <u>86</u> feet to <u>125</u> feet
Type of completion (check all applicable): Gravel packed Ur	nderreamed
Other (describe):	
Top of lap pipe or reduction in casing: Feet	
If telescoped or more than one	e screen, describe on next page

•	. '		For Office Use	-
ounty: Bolivar			well#: <u> </u>	i
ermit #: GW-50403				
		,		
he sketch below only requi	red for water wells	Description of formations encou	ntered must be provided for a	ll wells
7		and boreholes, unless specificall	v exempted by regulations	
well telescopes, show dept	ns on sketch.	Description of Formations Enc	ountered From (depth)	To (depth)
round level ——	~	Clay	Ground level	19 (deptil)
		Fine Sand	20	52
		Fine Sand & Gravel	53	67
		Med. Sand & Gravel	68	125
		11.04.04.14.04		
			· · · · · · · · · · · · · · · · · · ·	
	ł			
	:			
				ļ
more than one screen, s	show location of each on sketch			
ketch the property lay	out and include the following:	· · · · · · · · · · · · · · · · · · ·		
1) the well location	า			CEIVE AUG 07 21 34 OL'
	structures on the property that i	may aid in locating the well aid in locating the property and the v	all -	CEIVE
4) a north arrow	or mice, or early name that may	and in locating the property and the v	RE RE	2 2 2
				alig u " =
				- 1 /
			,,,,,,,,,,,,,,,,,,,,,,,,,,,,,,,,,,,,,,,	VOL
			ł l	3 \ T
		•		
andowner Name:		*		
	***************************************		Form: OI WR-S	WR-1A (04/08)
IEREBY CERTIFY th	at the well/borehole was drilled,	constructed, and completed in accor	dance with all applicable	
quirements of the Mis applicable, and state	ssissippi Department of Environ	mental Quality and the Mississippi De	partment of Health regulation	ons,
Atomicania and etata	iaws.	M /		

7-27-18Date

Signature of Licensee
Form: OLWR-SWR-1A (4/13)

Print Name of Responsible Licensee and License No.

County:	Bolivar
Permit #:	GW-50403
Driller: Irrigation Equipment, Inc.	
Date drilli	ing completed: 6-2-18
Copy	information from block on Part 1

STATE WELL REPORT Part 2

Pump Installer's Completion Report
Mississippi Department of Environmental Quality
Office of Land and Water Resources
P.O. Box 2309
Jackson, MS 39225-2309
(601) 961-5210
(601) 360-0535 (fax)

For Office Use Only:			
Well #:	T253		
Aquifer:			

Form: OLWR-SWR-1B (4/13)

(601	1) 360-0535 (fax).
This part of the report must be completed by a licensed water w	vell contractor or a licensed pump installer. A copy of Part 1 partment at the above address within 30 days of well completion.
Well Owner Information	Well Location
Owner Name: Giachelli Farms	Làtitude: 33° 33' 58.1"N Longitude: 90° 50' 38.5"W
Mailing Address: 44 Majori Road	Method of Lat/Long (check one): Conventional Survey,
	☐ USGS quad, ⊠ Hand-held GPS, ☐ Survey-grade GPS
Indianola MS 38751	<u>SE</u> ¼ <u>NW</u> ¼, Sec <u>20</u> T <u>20N</u> R <u>6W</u>
City State Zip code	
Telephone No	Miles West of Choctaw (Distance) (Direction) (Nearest Town)
Pump Ty	ype (check one)
☐ Submersible ☑ Turbine ☐ Air Lift ☐ Centrifugal ☐ Flowing	Well □ Jet □ Piston □ Rotary □ Other (describe):
	Rated Pump Capacity: 1900+/- Gallons Per Minute
Is This Pump (check one): ☑ New ☐ Repaired ☐ Replaceme	nt .
·	ype (check one)
	O 🗆 Windmill 🗀 Other (describe):
Horse Power Rating of Motor: 60 Setting Depth	n: _70 feet Number of Stages: _2
Duna Tota Data	San Nan Flanding Wall
-	for Non Flowing Well
Date Well Tested:	
Provide the I/P) (A): Feet Below Land Surface	e Pumping Water Level (B): Feet Below Land Surface
Mathed of recomment (alocal cost) To Chalden To The child	e Pumping Water Level (B): Feet Below Land Surface face Test Pumping Rate: Gallons Per Minute
The street of the decement of the least of the least to the least of t	Lapo [] 7 til sillo [] Ottlo! (docoribo).
-	ata for Flowing Well BY C
Measured shut in head: Feet	
Well yielded GPM with a drawdown of	feet after hours of pumping
Meter	Installation
Meter Manufacturer:	Meter Serial Number:
Meter Model Number/Name:	Type of Meter:
Totalizer Register Unit and Multiplier Factor (AF x .001, gal x 10	•
Installation Date: Meter installed by:	
ls This Meter (check one): ☐ New ☐ Repaired ☐ Replacement	
	ertifying that this meter was installed to manufacturer standards.
	proved meters is on the MDEQ website.
1 HEREBY CERTIFY that the above statements are true to the	best of my knowledge.
0695	7-27-18
Print Name of Pump Installer and License No. (if applicable)	Date Signature of Pump Installer

Department of Environmental Quality Office of Land and Water Resources P. O. Box 2309 Jackson, Mississippi 39225

PERMIT

TO DIVERT OR WITHDRAW FOR BENEFICIAL USE THE PUBLIC WATERS

This permit is issued to the landowner named below in accordance with the provisions of the Mississippi Water Laws, Mississippi Code Sections 51-3-1, et seq.(1972, as amended), and the regulations and standards as promulgated thereunder. Whether or not specifically named in this permit or in the applications for this permit, anyone using water from the diversion/withdrawal point described below shall do so in compliance with the provisions of this permit. Neither this permit, nor any authority conferred hereby, may be sold, conveyed, encumbered, assigned, or otherwise aliened, for any period of time or under any conditions whatsoever. This permit may not be modified, transferred or revoked without prior action by the Permit Board. Any attempts to modify, transfer or revoke this permit, or to take any other action on this permit, shall be invalid and unenforceable and may result in immediate revocation or suspension of this permit. The holder of this permit shall at all times be responsible for adherence to the terms and conditions of this permit. No agreement between the permit holder and any other party shall affect the obligations and liabilities of the permit holder. Water use under this permit is allowed only when the streamflow, lake level elevation, or static groundwater level (whichever, if any, is applicable) is above the established minimum, pursuant to Mississippi Code Section 51-3-7. Authorization is hereby granted to divert/withdraw water for the beneficial use designated herein, and for no other purpose, subject to the following terms, conditions, and limitations:

Permit Number: MS-GW-50403

Landowner Name: JARRETT GIACHELLI FARMS

Landowner Address: 44 MAJORI ROAD

INDIANOLA

MS 38751

Source Of Water: MISSISSIPPI RIVER VALLEY ALLUVIAL AQUIFER

Beneficial Use: IRRIGATION

Diversion/Withdrawal Location: SE 1/4 of the NW 1/4 Section: 20 Township:20N Range: 06W

> County: BOLIVAR Quad: SHAW

Maximum Volume: 60 Acre-Feet/Year equivalent to .0536 Million Gallons/Day RECEIVED AUG 07 2018 BY OLWR

Maximum Rate: 2500 Gallons/Minute

Applicant Name: JARRETT GIACHELLI FARMS

Applicant Address: 44 MAJORI ROAD

INDIANOLA MS 38751

Date Permit Issued: 05/30/2018 Date Permit Expires: 05/30/2023

Date Permit Modified: Date Permit Re-issued:

This permit shall be deemed null and void if construction has not begun within one (1) year of permit issue date


SPECIAL TERMS AND CONDITIONS: SEE ATTACHMENT 1, WHICH IS HEREBY DECLARED TO BE PART OF THIS PERMIT.

SPECIAL TERMS AND CONDITTIONS 2:

Gary C. Rikard, Executive Director

Mississippi Department of Environmental Quality



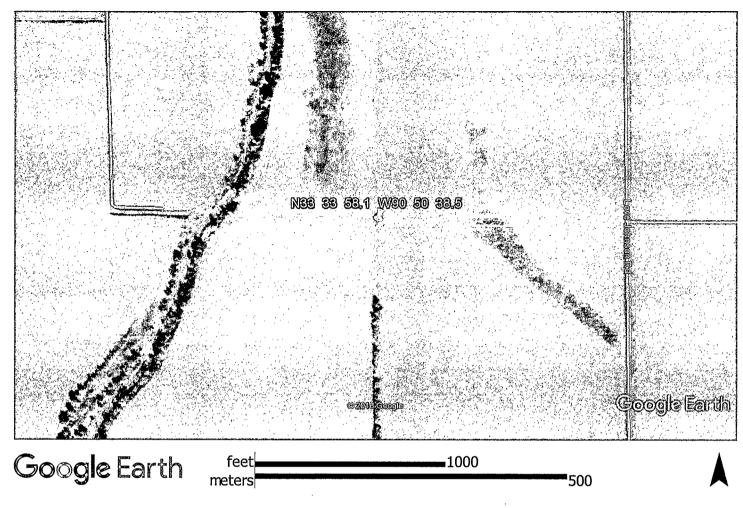

GW-50403

RECEIVED AUG 07 2018 BY OLWR