

Calhoun
B 12
7-68
Miss. Dept. of
July 1968
date well completed

MISSISSIPPI
BOARD OF WATER COMMISSIONERS
416 North State Street
Jackson, Mississippi 39201

CODED

WATER WELL DRILLERS LOG

Robert E. Kattigle
firm name
Calhoun
county well located

LANDOWNER: Arepta
Water Assn, Inc
Bruce Miss.
(mailing address)

WELL LOCATION:
sec. 16 T. 11 N. R. 1 E.
8 miles South of Bruce
(distance) (direction) (nearest town)


WELL PURPOSE: Community
(home, irrigation, municipal, industrial)

WELL COMPLETION DATA

- (1) diameter (inches) 8x7x6
- (2) total depth (feet) 1887
- (3) static water level (feet) 220 ^{below} top of ground
- (4) casing 4" St. 510' 28"
(material) (depth)
1337' 27"
(size) if telescopic see back.
- (5) screen 40 1847
(length) (depth to top)
6" P. Steel
(size) (material)
- (6) pump 30 150
(HP) (yield gpm)
electric
(type power)
- (7) electric log yes (USGS #40)
M.G. Survey
(organization running log)
- (8) how well bottom plugged BPV

description of formations encountered	depth	
	from	to
red clay	0	60
sand	60	90
shale	90	731
sandy shale	731	793
shale	793	1004
sandy shale	1004	1095
shale	1095	1482
sandy shale	1482	1705
sand	1705	1738
shale	1738	1805
sand	1805	1845
sand & gravel	1845	1887

CODED

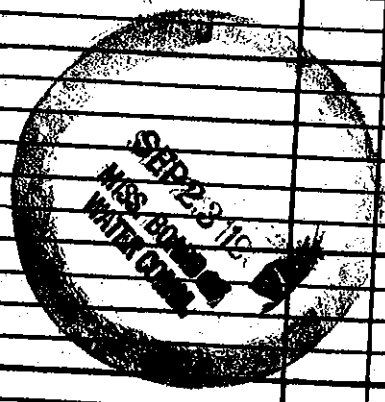

DRILLERS REMARKS: