

Calhoun
C 27
10-66

MISSISSIPPI BOARD OF WATER COMMISSIONERS **CODED**

WATER WELL DRILLERS LOG

Date: Oct. 13, 1966, Driller: Jerry Roberson County Calhoun
(When well drilled) (Name) (Where well is located)

(1) Owner of Land:	Description & Color of Materials Sand, Clay, Red Clay, Shell, etc.	Thick- ness Feet	Depth Feet
<u>Jack Mc Kibbins</u> <small>(Name)</small>	<u>Red Clay</u>	<u>20</u>	<u>20</u>
<u>Rt. 2, Bruce, Mississippi</u> <small>(Address)</small>	<u>Clay + Blue Sand</u>	<u>40</u>	<u>60</u>
(2) Location: <u>SE 1/4, SW 1/4, Sec. 17, T. 12 N., R. 2 W.</u>	<u>Blue Shale</u>	<u>100</u>	<u>160</u>
<u>7</u> miles SE <u>NW</u> of <u>Bruce</u> <small>(distance) (direction) (Nearest Town)</small>	<u>Sand + Shale</u>	<u>80</u>	<u>240</u>
(3) Topography: <input checked="" type="checkbox"/> (Hilly) <input type="checkbox"/> (Flat) <input type="checkbox"/> (Level)	Sand		
(4) Purpose of Well: <u>Home</u> <small>(Domestic Irrigation, Municipal, Industrial, Other)</small>			

Information upon completion of well:

(1) Diameter 4 inches.

(2) Total Depth 240 feet.

(3) Water Level 50 feet below top of ground.

(4) Cased to 235, Size 4 in.

(5) Screen: Size 6 in., Length 5 ft.

(6) Were any formations sealed against pollution?
 yes, no.

CODED

If YES depth of formation _____


Why _____

Drillers Remarks: Plastic Water Well

Yield in gpm: 18

Size pump: 1/2 H.P. Submerga

Type power: 220-T.V.B.

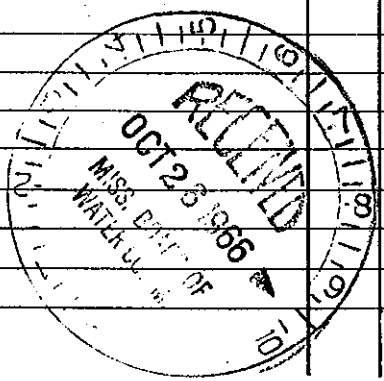

Mail this copy to Board of Water Commissioners 429 Miss. St. Jackson, Miss.