

MISSISSIPPI DEPARTMENT OF ENVIRONMENTAL QUALITY
Office of Land and Water Resources

P. O. Box 10631
Jackson, MS 39289-0631

WATER WELL DRILLERS LOG

COUNTY WELL LOCATED
Chickasaw

WELL NUMBER
MT, MOUNTAIN #2

CODED
D0008

DATE WELL COMPLETED
1-2-2004

PERMIT NUMBER
20041134

NAME OF DRILLING FIRM
BASS & PARTS LOCAL SERVICE INC

DATE
HDT# 070011-02

NAME & MAILING ADDRESS OF LANDOWNER
MT. COMBET WATER ASSN,
Blue MS

Latitude 34° 00' 20"

Longitude 89° 18' 18"

WELL LOCATION SEC 16 TOWNSHIP 12 N RANGE 1 E

DISTANCE 5 MILES EAST of BLUE

NEAREST TOWN

OTHER LANGUAGE

WELL PURPOSE: Home, Industrial, Municipal, Institutional, Fish/Pond, etc.

PUMP DATA

PUMP TYPE (Circle One): Submersible, Turbine, Jet, Flowing Well

POWER TYPE (Circle One): Electric, Tractor, Diesel, Gasoline, Butane, Other (Describe)

DESCRIPTION OF FORMATIONS ENCOUNTERED FROM TO

RED SAND & CLAY	0	100
CLAY	100	400
CLAY - SAND CLAY	400	1320
CLAY - SILT	1320	1400
SAND	1400	1725
SAND - GRAVEL	1725	1805

WELL DATA

Casing Diameter (in.) 12

Casing Length (ft.) 1725

Well Depth 1790

Depth to Static Water Level 213

TYPE OF COMPLETION (Circle One or More): Gravel Packed, Underscreened, Telescoped, Natural Development, Open Hole, Other

WELL GROUDED TO A DEPTH OF 1725 FEET

Type Grout (circle one): Cement, Bentonite, or Mix

SCREEN DATA

Screen Type 55

Length - Feet 60

Slot Size - Inches 0.020

Depth to Bottom - Feet 1990

SECTION

Please indicate well location X

Pump Capacity (GPM)	300
No. of Stages	10
Running Depth	320

Well yielded 300 GPM

a drawdown of 32' after 4 hours of pump

LOG DATA

TYPE OF LOG RUN (Circle One): No Log, Electric, Gamma Ray, Density, Sonic, Neutron, Other (Describe)

Name of Organization Running Log: MMSG

GROUND LEVEL


CASING

CEMENT

WAP PIPE

Block Jack

Screen

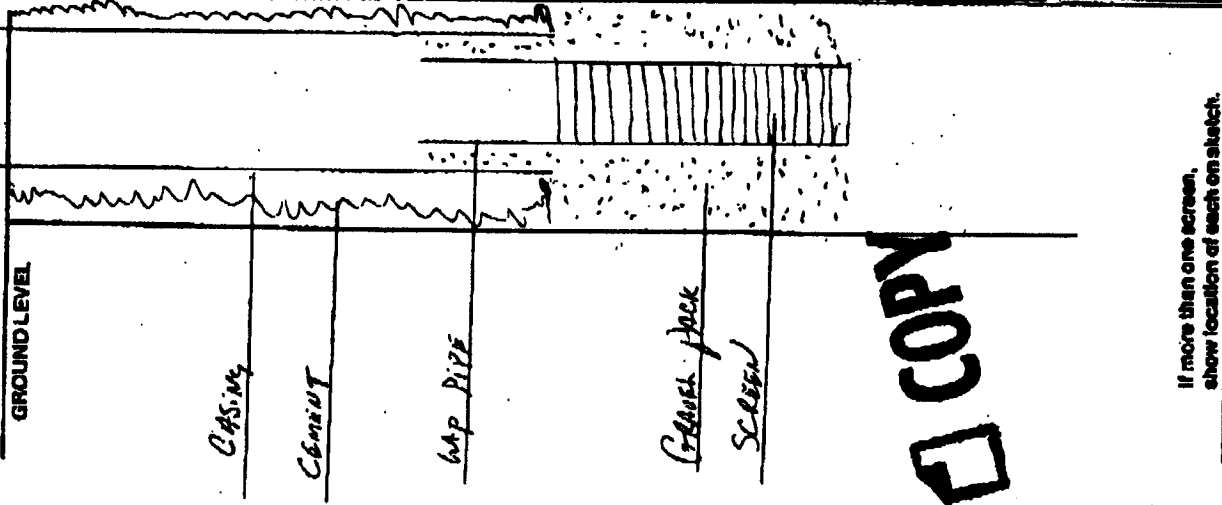

COPIY

I certify that the well was drilled, constructed and completed in accordance with all applicable Requirements of the Mississippi Department of Environmental Quality and/or the Mississippi Department of Health regulations and state laws.

Signature of Licensed Driller and License No. Raymond S. 0-414

Date Jan 2, 2004

Additional Information Required On Back