

CALHOUN MISSISSIPPI BOARD OF WATER COMMISSIONERS

E 33
7-20-60


WATER WELL DRILLERS LOG

Shown in Bull. #92 - E33

South?

Date: July 20, 1960, Driller: T. M. Parks County Calhoun
(Name)

	Description & Color of Materials Sand, Clay, Red Clay, Shell, etc.	Thick- ness Feet	Depth Feet
(1) Owner of Land: <u>A. C. Brasher</u> Route # _____ <u>Bruce, Mississippi</u> (Name) (Address)	Hole has impossible description.		
(2) Location: <u>3/4</u> , <u>31 125 1 E</u> <u>7</u> miles <u>east</u> of <u>Bruce</u> (distance) (direction) (Nearest Town)	From the top to 425 ft. the sand, rock and black shell and various other formations. From 425 ft. to 680 ft. sand and shell. (Sand dry)		
(3) Topography: <u>Hilly</u> (Hilly) (Flat) (Level)	From 680 ft. to 1290 ft. chalk and shell.		
(4) Purpose of Well: <u>Domestic</u> (Domestic Irrigation Municipal, Industrial, Other)	Balance sand	96	
Information upon completion of well:			
(1) Diameter <u>4</u> inches.			
(2) Total Depth <u>1386</u> feet.			
(3) Water Level <u>159</u> feet below top of ground.			
(4) Cased to <u>425 ft.</u> , Size <u>4 inch</u>			
(5) Screen: Size <u>2 inch</u> , Length <u>84 ft.</u>			
(6) Were any formations sealed against pollution? <u>X</u> yes, _____ no.			
If YES depth of formation _____			
Why _____			
Drillers Remarks: <u>Well was cased 425 ft. against pollution, and black water formation. Balance of well 2 inches into water sand.</u>			

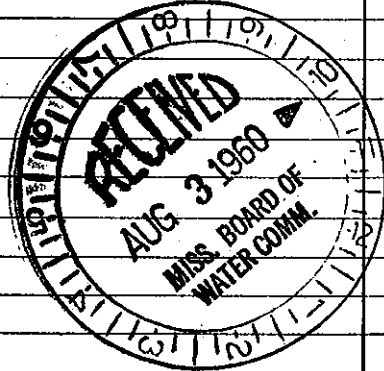

Well No. E 33

(Use Back Side)

Mail this copy to Board of Water Commissioners 429 Miss. St. Jackson. Miss